
HAROLD H. KOLB

REGISTERED PROFESSIONAL LAND SURVEYOR LAKE GENEVA, WISCONSIN

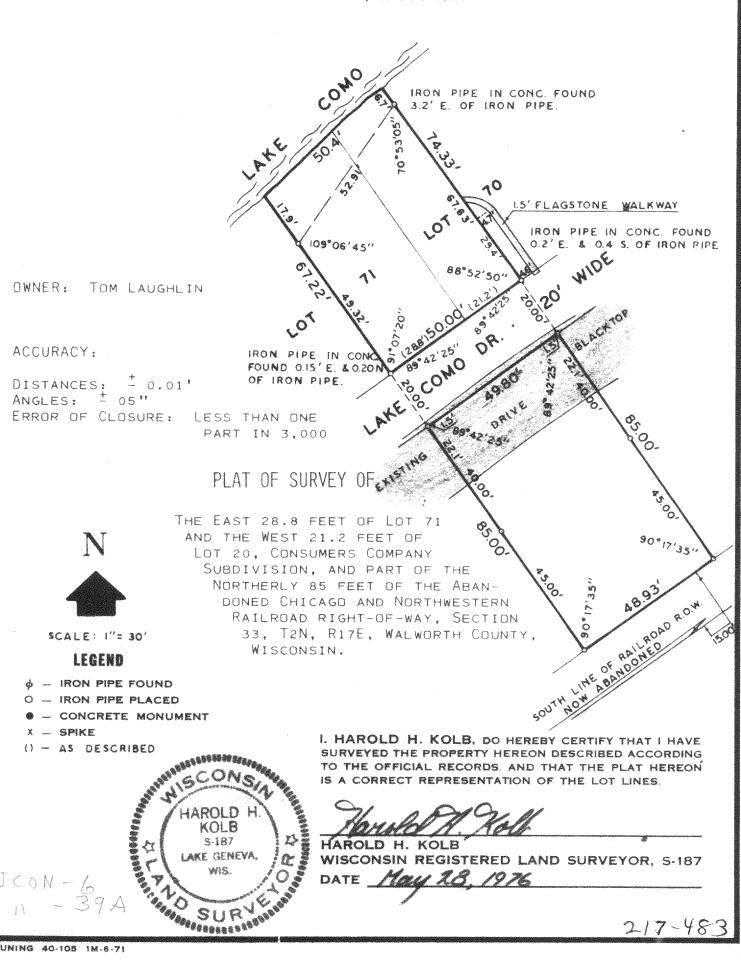

HAROLD H. KOLB

DATE May 28, 1976

WISCONSIN REGISTERED LAND SURVEYOR, S-187

217-483