

LAND-MARK SURVEYING

Mark L. Miritz

Wisconsin Professional Land Surveyor S-2582


N9330 Knuteson Drive
Whitewater, WI 53190
Phone: (262) 495-3284
MARKMIRITZ@

LAND-MARKSURVEYING.COM

PLAT OF SURVEY

ORDERED BY:
SAL DIMICELI JR.
LAKE GENEVA AREA REALTY
101 BROAD STREET, SUITE C3
LAKE GENEVA, WI 53147

LOT 3, TRINITY MOUNTAIN ESTATES TOGETHER WITH AN EASEMENT FOR INGRESS AND EGRESS OVER AND ACROSS THE PRIVATE ROADS, IN TRINITY MOUNTAIN ESTATES, A SUBDIVISION LOCATED IN THE SOUTHEAST 1/4 OF SECTION 13 AND THE NORTHEAST 1/4 OF SECTION 24, TOWN 2 NORTH, RANGE 17 EAST, TOWN OF GENEVA, WALWORTH COUNTY, WISCONSIN.

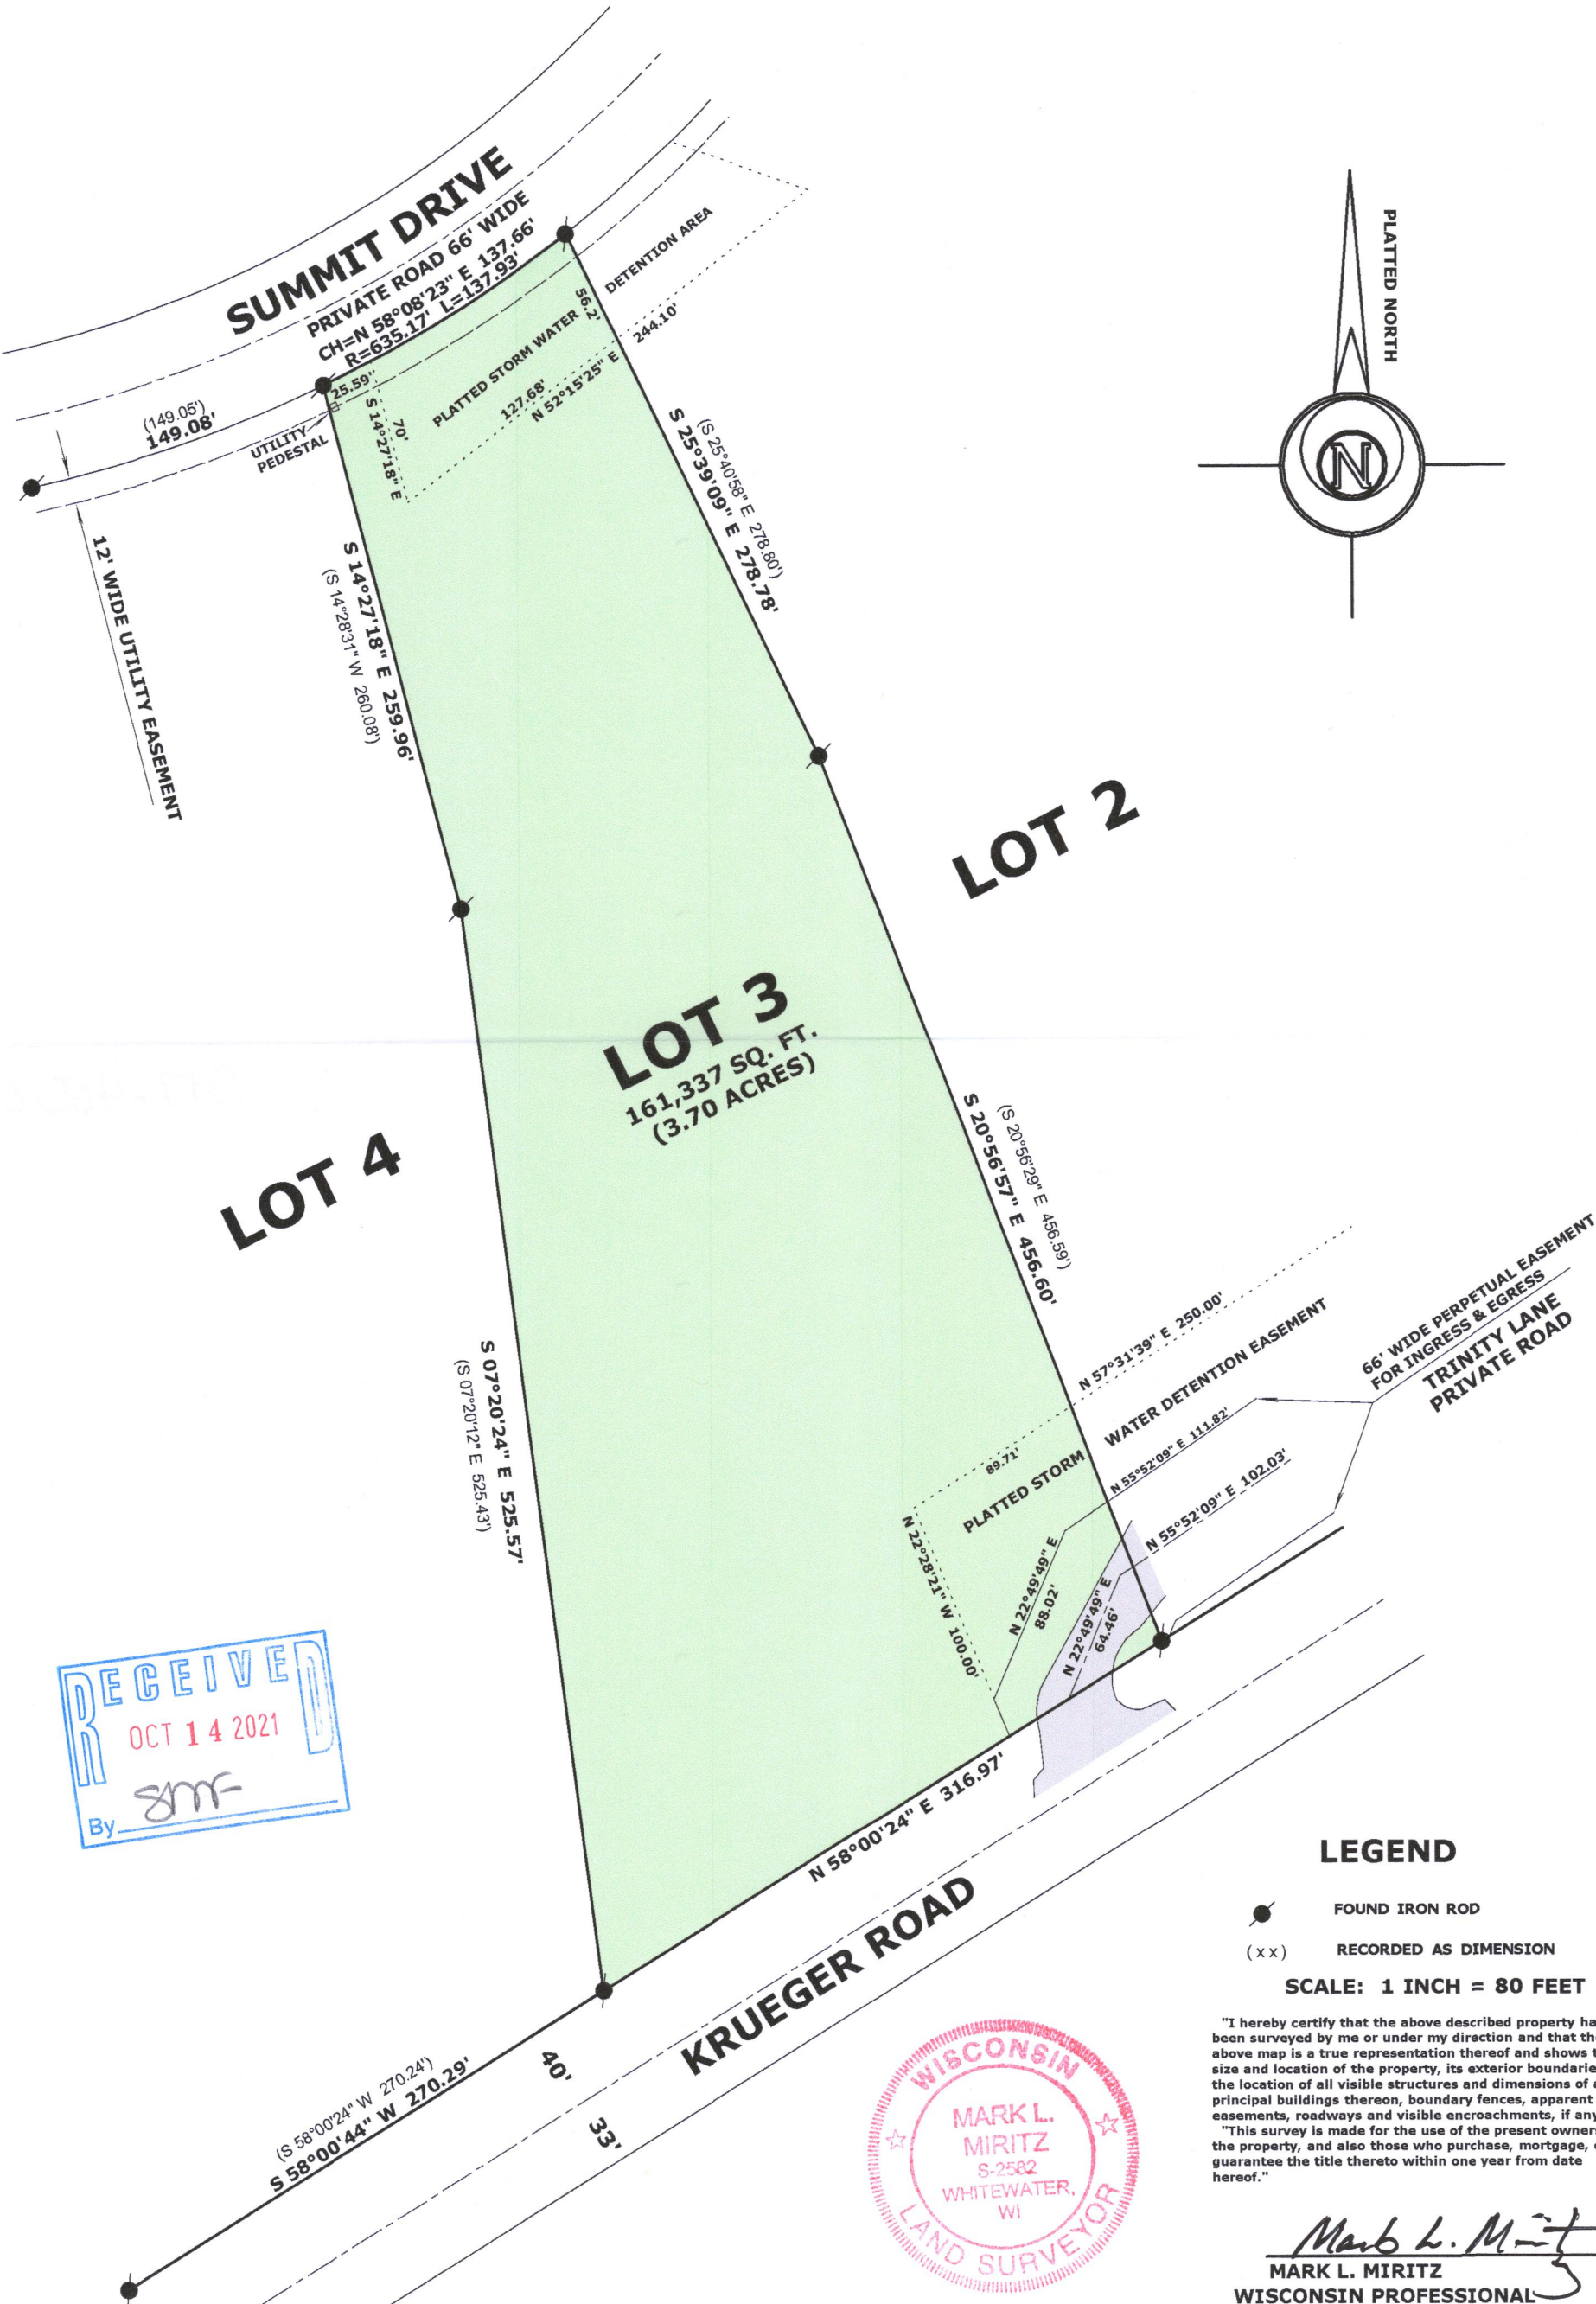

DATE: SEPT. 22, 2021 JOB NO. 21.907