
PLAT OF SURVEY

LOCATION: W2516 Trinity Lane, Geneva, Wisconsin

LEGAL DESCRIPTION:

Lot 3 of CERTIFIED SURVEY MAP NO. 4955, being a Certified Survey Map of the Northeast 1/4 of the Southeast 1/4 and part of the Southeast 1/4 of the Southeast 1/4, all in Section 13, Town 2 North, Range 17 East, in the Town of Geneva, Walworth County, Wisconsin.

November 11, 2021 Survey No. 112473-B

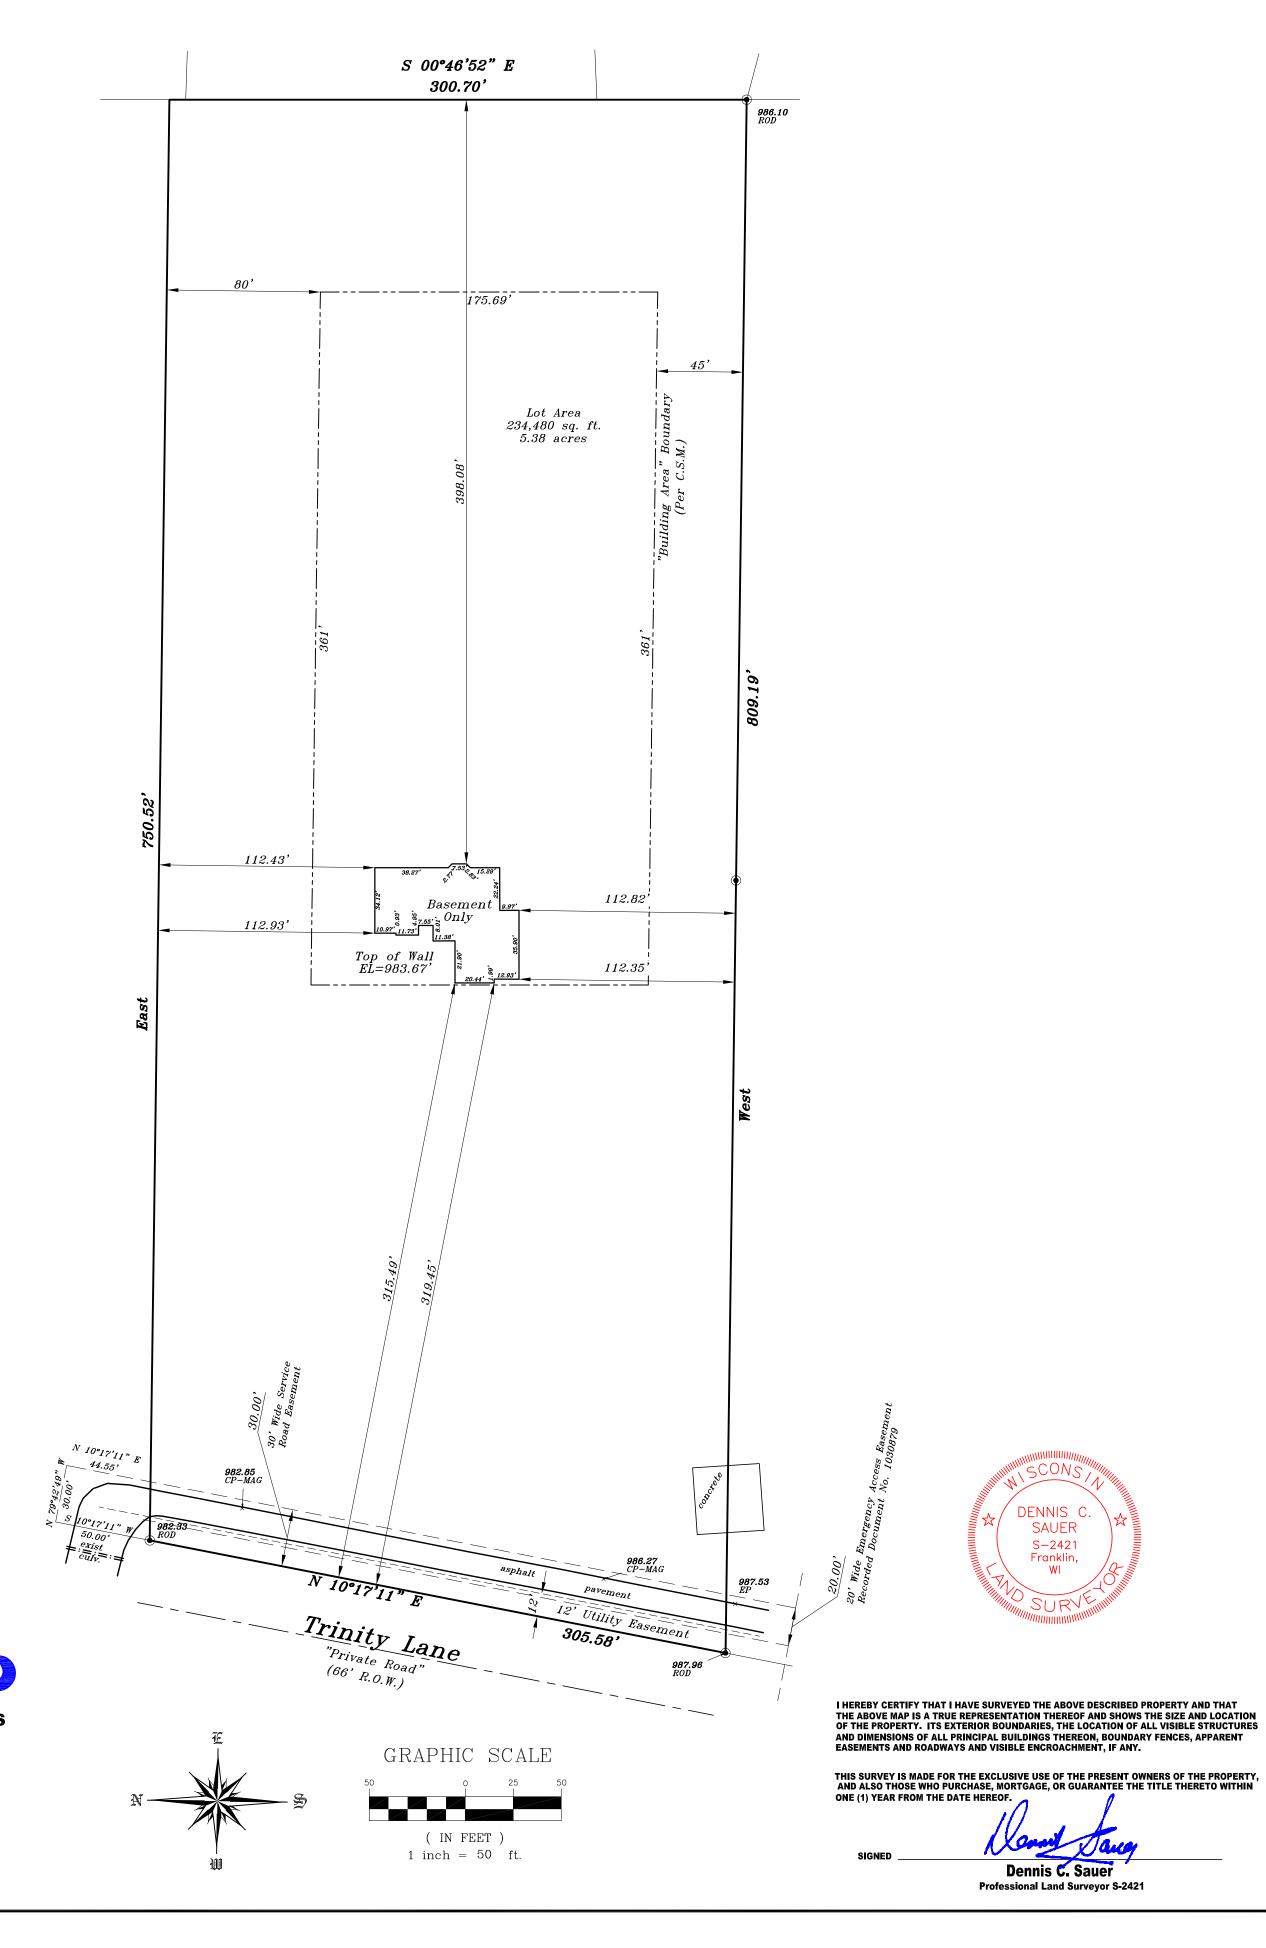

Prop. Gar. Slab 983.00,

Prop. T.O.W. 983.33'

Prop. Fin. Yd. Gr. 982.67'

Proposed finished yard, 1st floor or top of foundation grade shown on this drawing is a suggested grade and should be verified by the owner, builder or municipality

METROPOLITAN SURVEY SERVICE, INC.

PROFESSIONAL LAND SURVEYORS

9415 West Forest Home Avenue, Suite 202
Hales Corners, Wisconsin 53130
PH. (414) 529-5380
survey@metropolitansurvey.com
www.metropolitansurvey.com

● — Denotes Iron Rod Found
 ● — Denotes Iron Pipe Set
 ─ O00.0 — Denotes Proposed Grade