


# PLAT OF SURVEY

## LOTS 8917 THROUGH 8921 OF BLOCK 160 OF FOURTH MAP OF LAKE COMO BEACH, A SUBDIVISION


LOCATED IN PART OF THE SE 1/4 OF THE SE 1/4 OF SECTION 21, TOWN 2 NORTH, RANGE 17 EAST, WALWORTH COUNTY, WISCONSIN

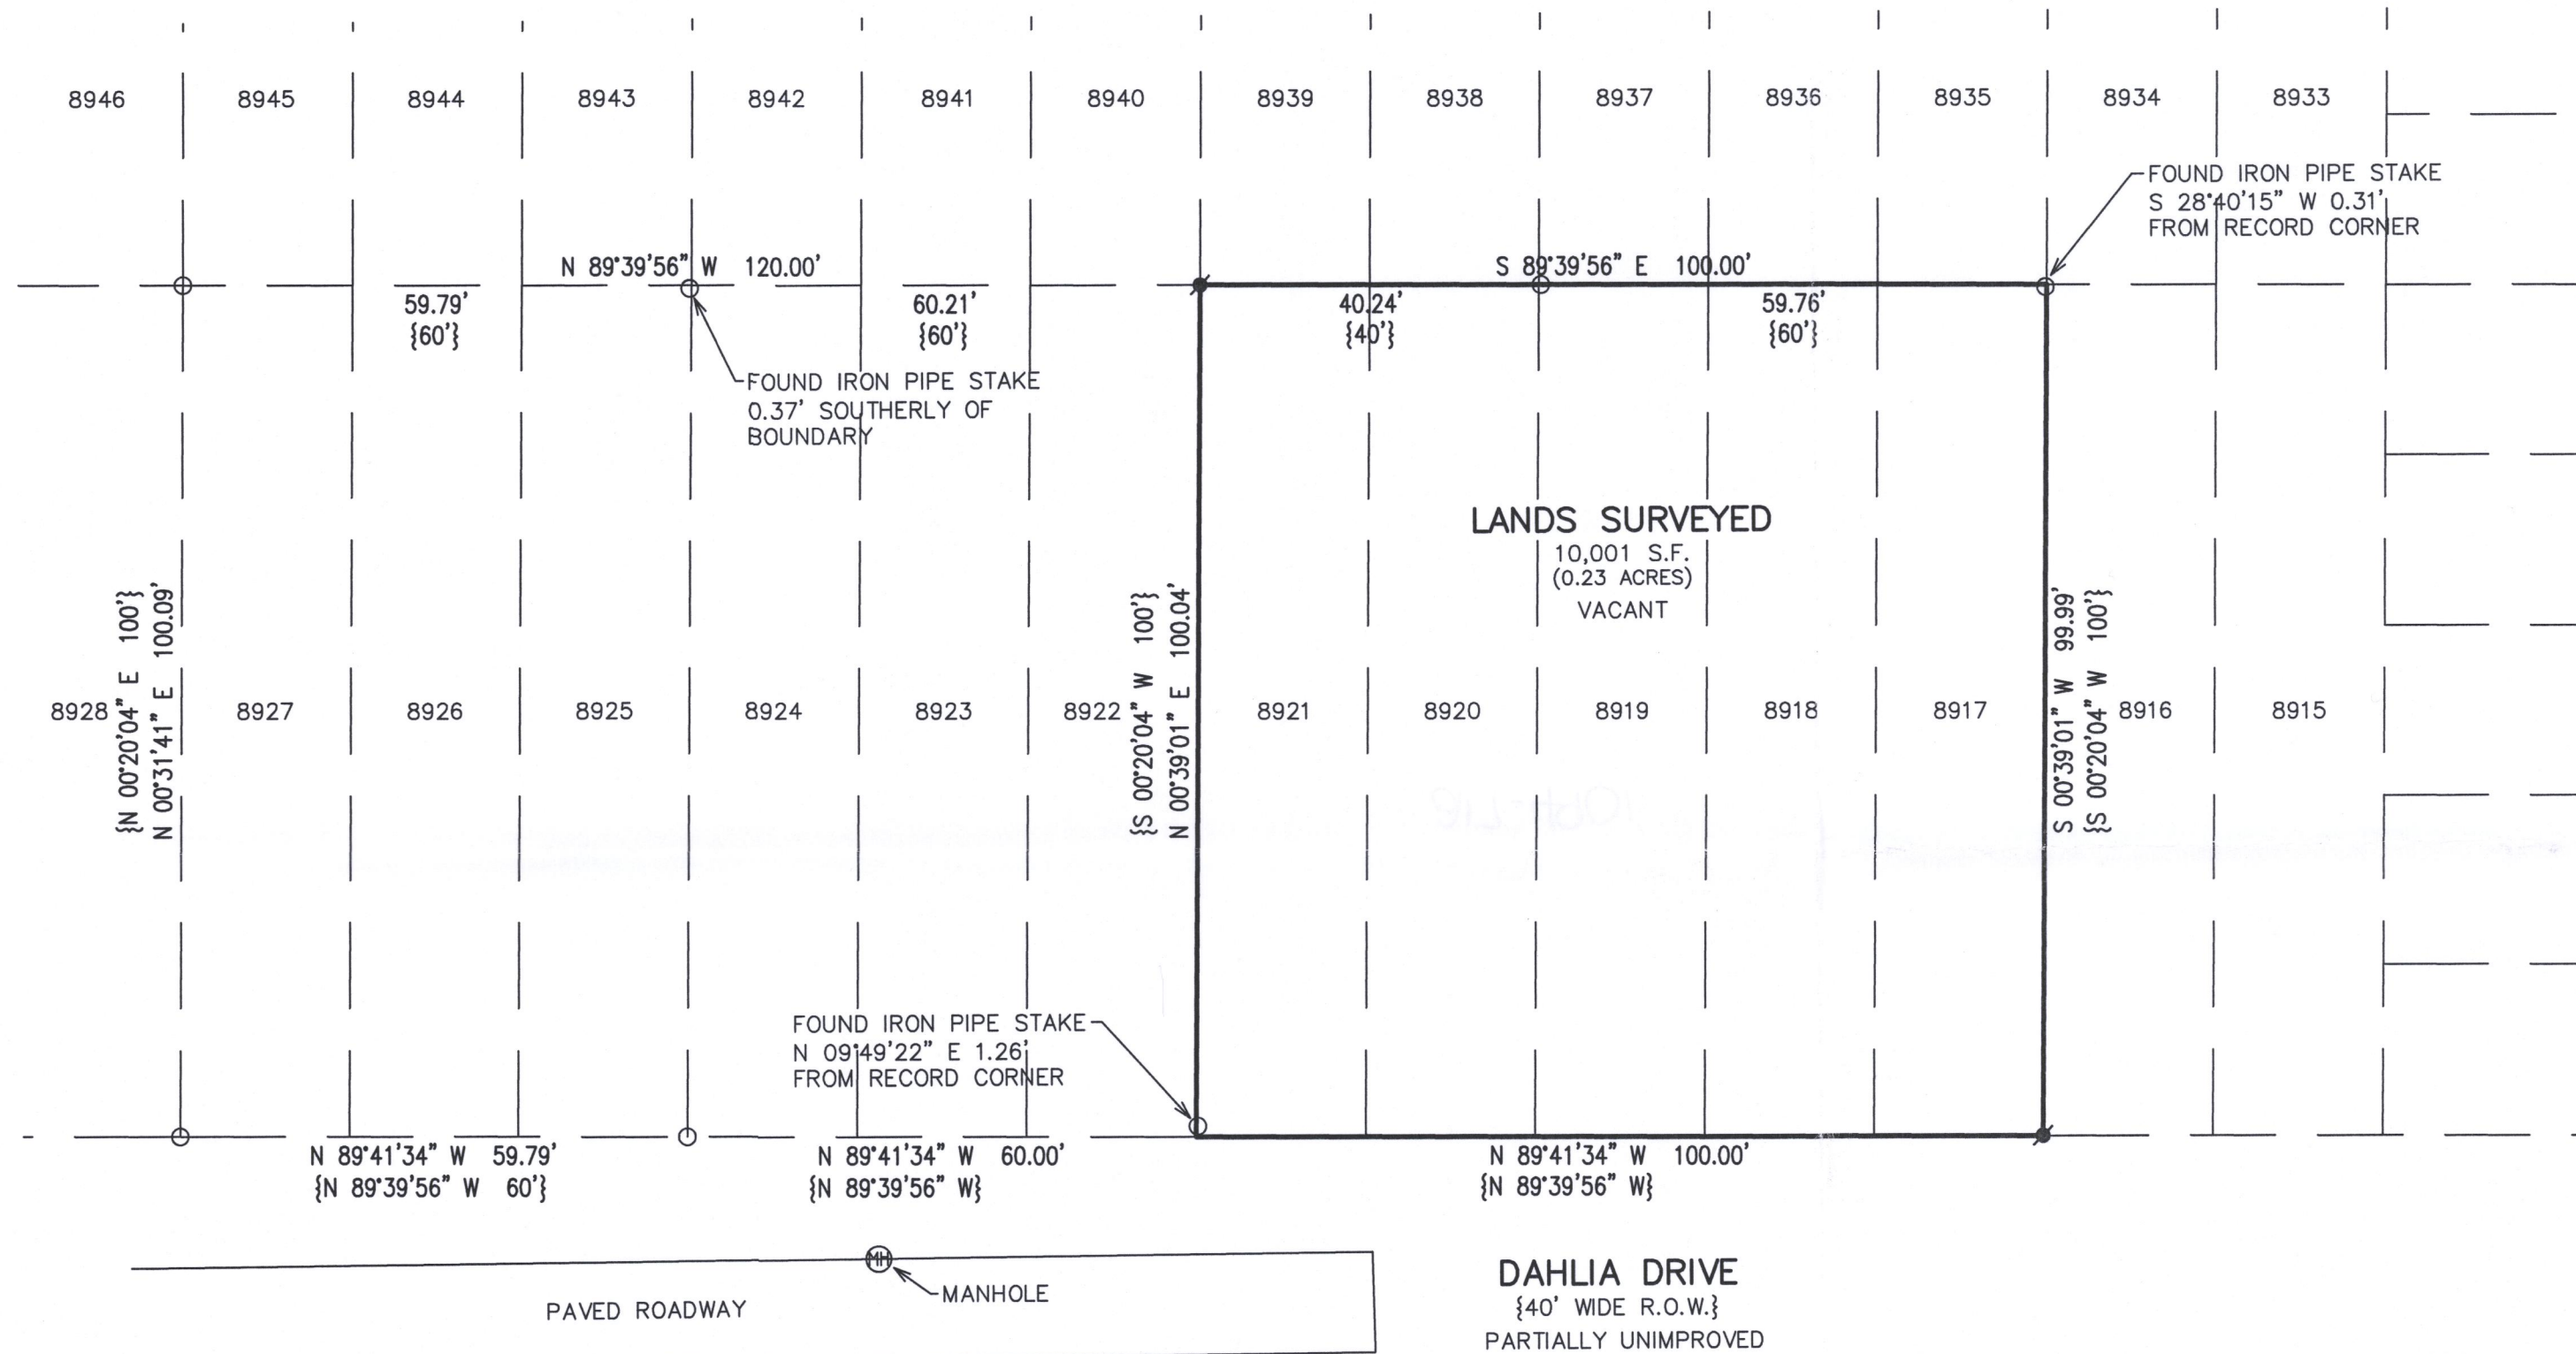

ASSIGNED THE NORTHERLY BOUNDARY OF LANDS SURVEYED  
S 89°39'56" E PER RECORD PLAT

### LEGEND

- O = FOUND IRON PIPE STAKE
- = SET IRON REBAR STAKE
- {XXX} = RECORDED AS

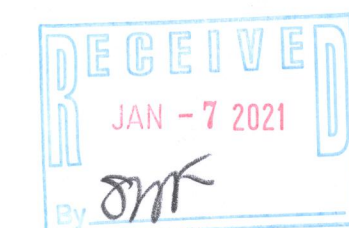


NOTE: COPIES OF THIS MAP TO WHICH THE FOLLOWING CERTIFICATE WILL APPLY SHOW THE SURVEYOR'S ORIGINAL SEAL AND SIGNATURE IN RED INK. COPIES BY ANY OTHER MEANS MAY HAVE ALTERATIONS WHICH DO NOT REPRESENT THE SURVEYOR'S WORK PRODUCT.

I HEREBY CERTIFY THAT THE ABOVE DESCRIBED PROPERTY HAS BEEN SURVEYED UNDER MY DIRECTION AND THAT THE ABOVE MAP IS A TRUE REPRESENTATION THEREOF AND SHOWS THE SIZE AND LOCATION OF THE PROPERTY AND ITS EXTERIOR BOUNDARIES. THIS SURVEY IS MADE FOR THE USE OF THE PRESENT OWNERS OF THE PROPERTY, AND ALSO THOSE WHO PURCHASE, MORTGAGE, OR GUARANTEE THE TITLE THERETO WITHIN ONE YEAR FROM THE DATE HEREOF.

DATED: 11/5/2021

*Christopher A. Hodges*  
CHRISTOPHER A. HODGES P.L.S. 2760

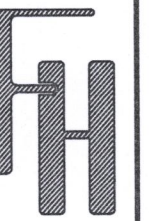

PLAT OF SURVEY  
LAKE GENEVA, WISCONSIN

WORK ORDERED BY --  
LAURA PEREZ  
N3371 IVY ROAD  
LAKE GENEVA, WI 53147

FARRIS, HANSEN & ASSOCIATES, INC.  
ENGINEERING - ARCHITECTURE - SURVEYING  
7 RIDGWAY COURT P.O. BOX 437  
ELKHORN, WISCONSIN 53121  
OFFICE: (262) 723-2098 FAX: (262) 723-5886

### REVISIONS

PROJECT NO.  
10573  
DATE:  
11/05/2021  
SHEET NO.  
1 OF 1