Certificate


The above-described property has been surveyed under my direction and the map hereon drawn is a correct representation thereof to the best of my knowledge and belief.

No title commitment or results of a title search were provided to this office pertaining to this easements of record, encumbrances, restrictions, ownership, title evidence, or other facts that a current and accurate title search may disclose.

05/18/2023 l





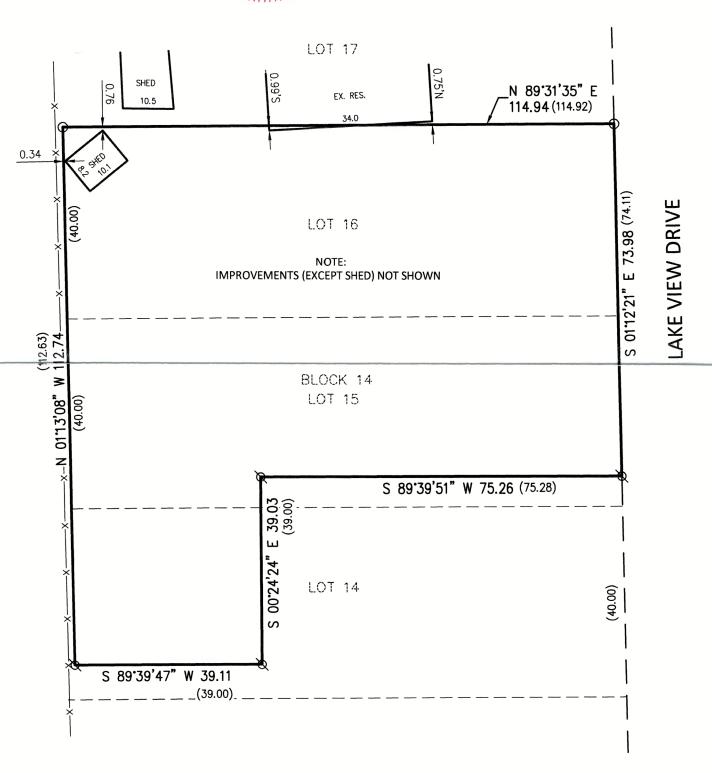

NOTE

BEARING BASE: GRID NORTH, WISCONSIN COORDINATE SYSTEM, SOUTH ZONE. BASED UPON NAD 1983 / 2011.

LEGEND

O IRON PIPE FOUND

☒ IRON BAR FOUND

-x — FENCE



Nielsen Madsen + Barber

CIVIL ENGINEERS AND LAND SURVEYORS 1458 Horizon Blvd. Suite 200, Racine, WI. 53406 Tele: (262)634-5588 Website: www.nmbsc.net

FIELD WORK 5-17-2023 BY JWP/KRF DRAWN 5-18-2023 BY SCB SCALE 1" = 20' SHEET 1 OF 1 SHEETS

JOB NO. 2023.0083.01

00018A

₹ 10:30:02

2023 8,