



## PLAT OF SURVEY

Unit 4-37, in Geneva National Condominium No. 4 Condominium, created by a Declaration of Condominium recorded on May 24, 1990, in the Office of the Register of Deeds for Walworth County, Wisconsin in Volume 487, pages 101 through 148, as Document No. 194543, and by a Condominium Plat therefore.

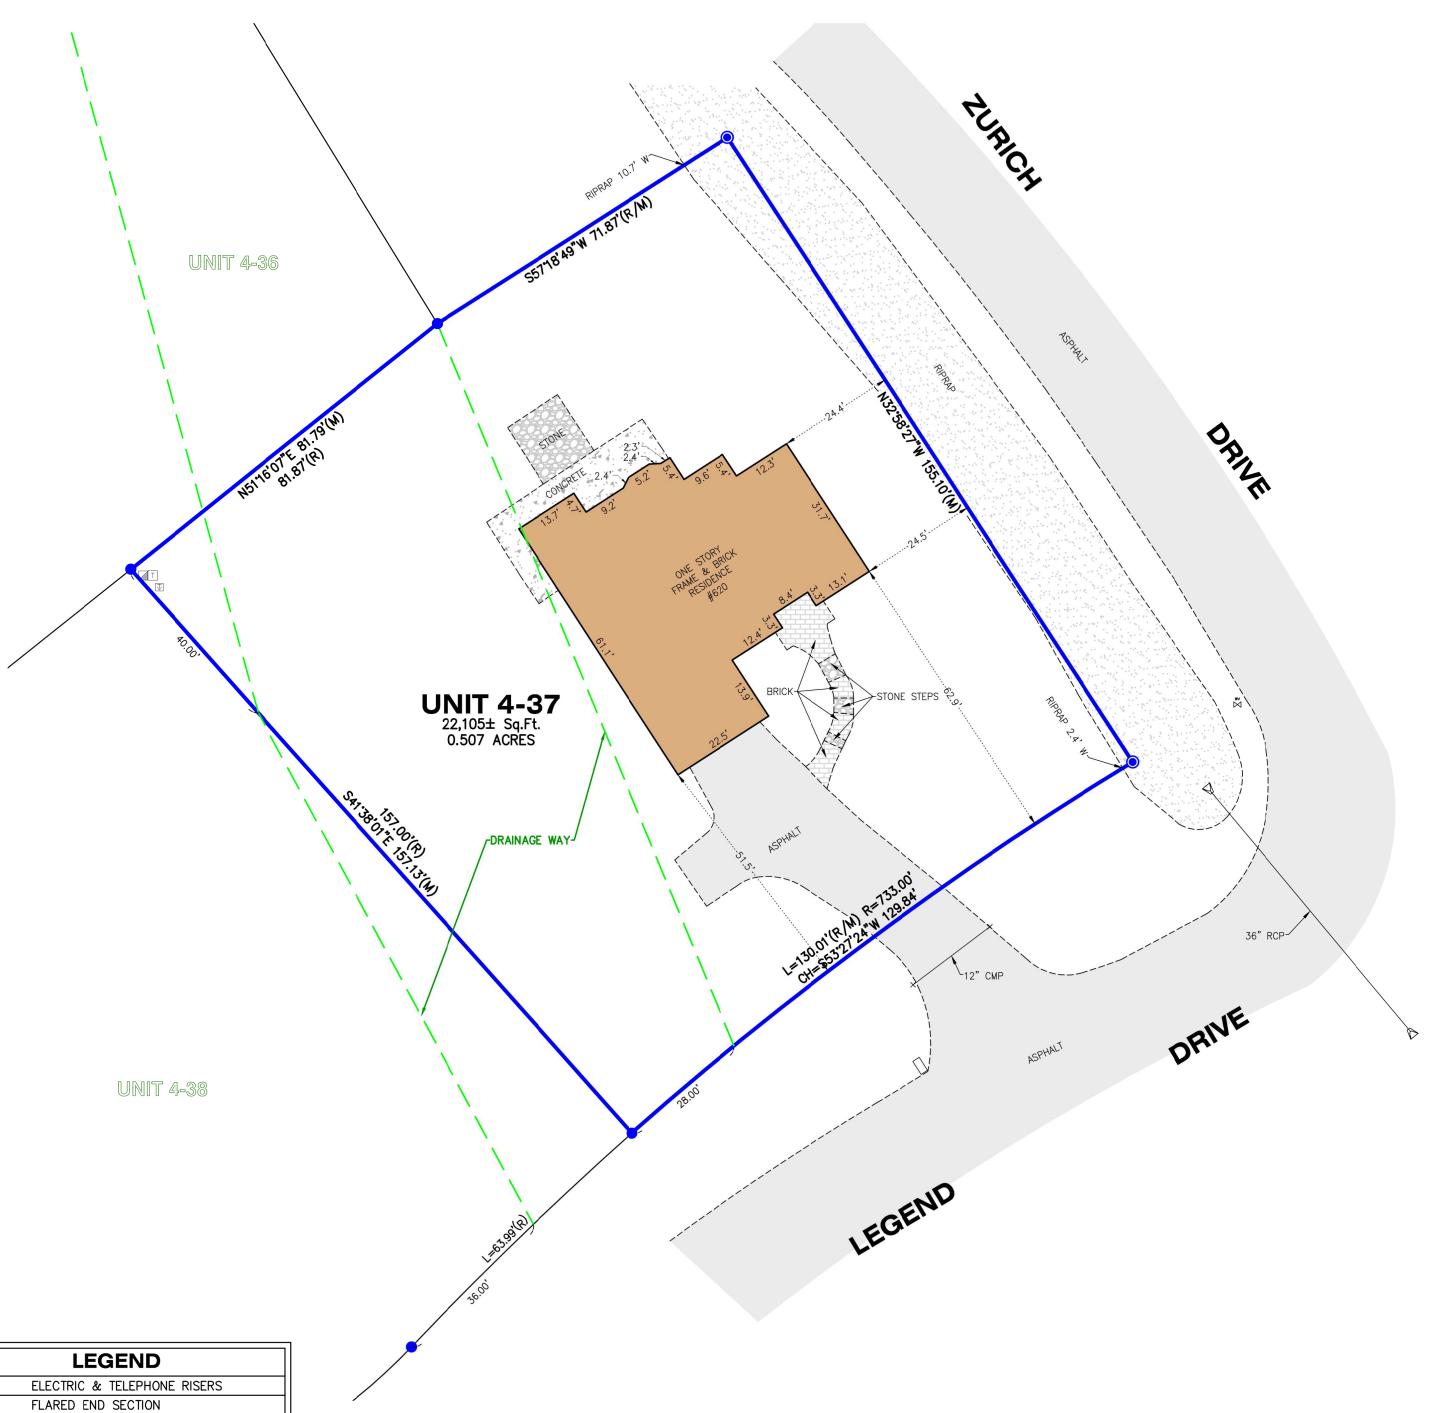

LEGEND	
T	ELECTRIC & TELEPHONE RISERS
Δ	FLARED END SECTION
•	FOUND IRON BAR
	MAIL BOX
•	SET IRON BAR
$\overline{\mathbf{v}}$	TV RISER
×	WATER VALVE
(M)	MEASURED
(R)	RECORD

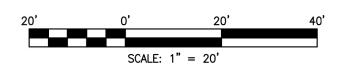

CLIENT: BERKSHIRE HATHAWAY HOME SERVICES DRAWN BY: TPS CHECKED BY: APG SCALE: <u>1"=20</u>' SEC. 30; 31 T. 02 R. 17 E. BASIS OF BEARING: WI S. ZONE NAD83/2011 P.I.N.: JGN 400037

JOB NO.: 230845 FIELDWORK COMP.: 10/04/23 BK. ALL DISTANCES SHOWN IN FEET AND DECIMAL REF: PARTS THEREOF CORRECTED TO  $68^{\circ}$  F.


NOTE: Only those Building Line Restrictions or Easements shown on a Recorded Subdivision Plat are shown hereon unless the description ordered to be surveyed contains a proper description of the required building lines or easements.

\* No distance should be assumed by scaling. \* No underground improvements have been located

unless shown and noted. \* No representation as to ownership, use,

or possession should be hereon implied. \* This Survey and Plat of Survey are void without original embossed or colored seal and signature affixed.

Compare your description and site markings with this plat and AT ONCE report any discrepancies which you may find.

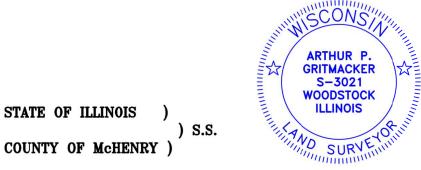

In my professional opinion, and based on my observations, I hereby certify that the above described property has been surveyed under my direction and that the above map is a true representation thereof and shows the size and location of all visible structures, and dimensions of all principle buildings thereon, boundary fences, apparent easements, roadways, and visible encroachments, if any. This survey is made for the use of the

present owners of the property, and also those who purchase, mortgage, or guarantee the title thereto within one year from the date hereof.

Dated at Woodstock, McHenry County, Illinois 10/09 A.D., 2023.

Vanderstappen Land Surveying, Inc. Design Firm No. 184-002792

STATE OF ILLINOIS

Wisconsin Registered Land Surveyor No. S3021

