
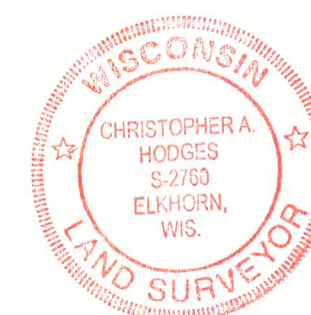
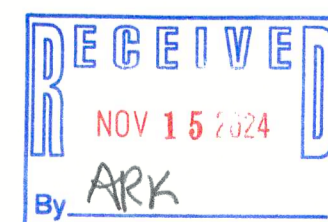
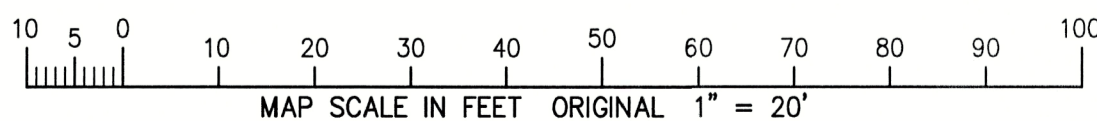
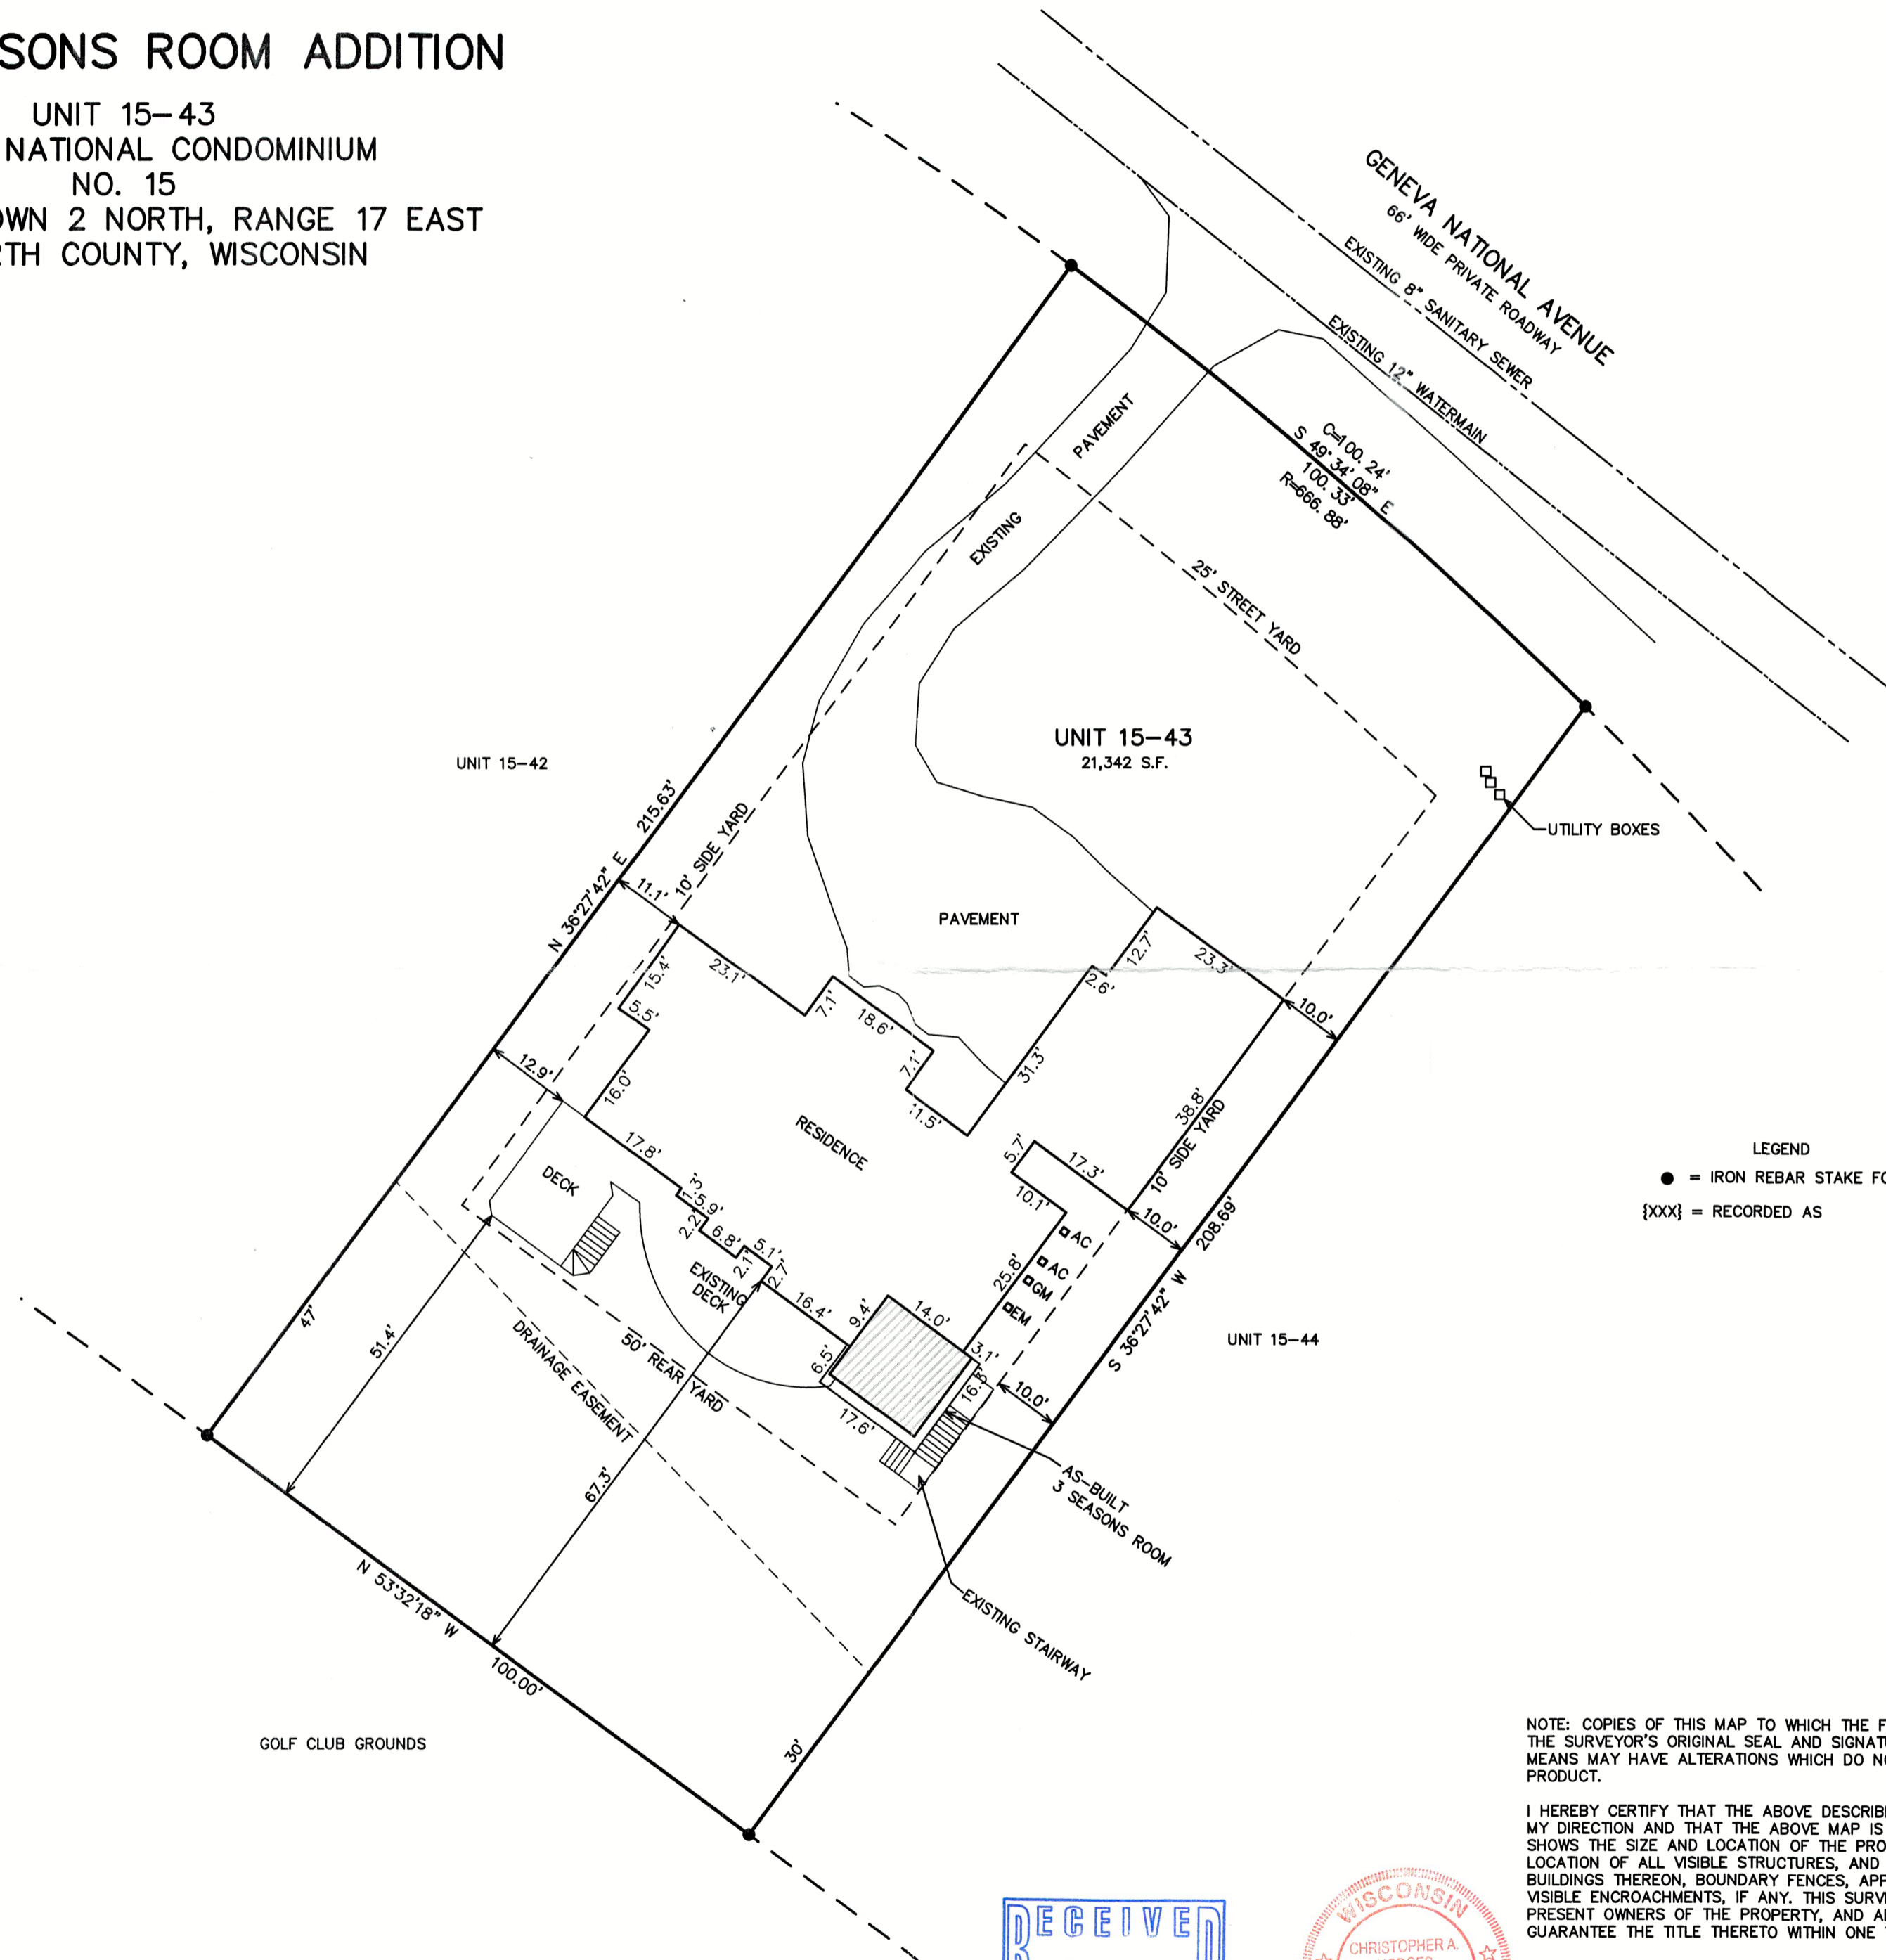


AS-BUILT  
THREE SEASONS ROOM ADDITION

UNIT 15-43  
GENEVA NATIONAL CONDOMINIUM  
NO. 15  
LOCATED IN TOWN 2 NORTH, RANGE 17 EAST  
WALWORTH COUNTY, WISCONSIN

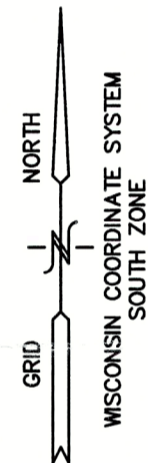

DATED: 03-25-2024

CHRISTOPHER A. HODGES



WORK ORDERED BY -  
STROM CONTRACTING, LLC  
3817 TULIP STREET  
CRYSTAL LAKE, IL 60014

FARRIS, HANSEN & ASSOCIATES, INC.  
Engineering, Architecture, Surveying  
7 Ridgway Court P.O. Box 437  
ELKHORN, WISCONSIN 53121  
Office: (262) 723-2098  
Fax: (262) 723-5886

REVISIONS  
03/25/2024  
UPDATED FOR  
3-SEASONS ROOM

PROJECT NO.  
3269-15-43.13  
DATE:  
7/11/2013  
SHEET NO.  
1 OF 1