



Plat of Survey

of
**Lots 210 through 214 in Block 6 of
the Third Map of Lake Como Beach,**
a subdivision located in the Southeast 1/4 of the Southeast 1/4 of Section 22,
Town 2 North, Range 17 East, Town of Geneva, Walworth County, Wisconsin.

Surveyed for: **Kurt & Alissa Jennison**
W3382 County Road H
Lake Geneva, Wisconsin. 53147

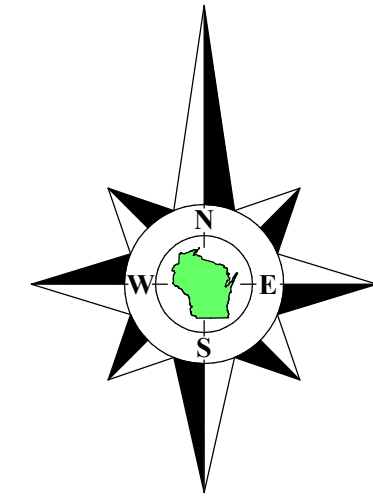

Bearings referenced to the West line of Elm Road,
recorded as N0°20'04"E on the plat of the Third
Map of Lake Como Beach.

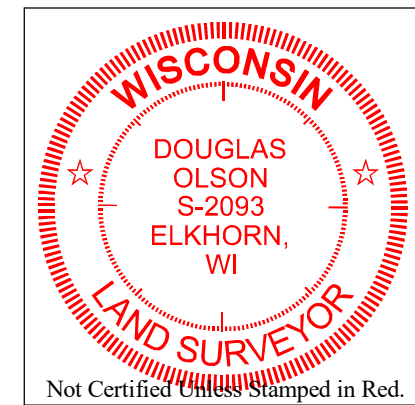

Notes:

- 1) This Plat of Survey is not certified unless signed and sealed in red ink.
- 2) This survey is subject to Wisconsin lien laws. This Plat of Survey is the notice of intent to file lien. Lien waiver required.
- 3) The Survey Date shown on this Plat of Survey is the completion date of the field work.

Copyright ©2021 by Olson Land Surveying, LLC.


All rights reserved. No part of this survey plat may be reproduced or transmitted in any form by any means - graphic, electronic, or mechanical, including photocopying, tracing, or information storage and retrieval systems - without permission in writing from Douglas G. Olson, Olson Land Surveying, LLC.

I hereby certify that I have surveyed the above described property in compliance with Chapter A-E 7 of the Wisconsin Administrative Code and that the map hereon is correct to the best of my professional knowledge and belief and shows the size and location of the property, its exterior boundaries, the location and dimensions of all visible structures thereon, boundary fences, apparent easements and roadways and visible encroachments, if any.


This survey is made for the exclusive use of the present owners of the property, and also those who purchase, mortgage or guarantee title thereto, within one year from the date hereof.

Douglas G. Olson
Wisconsin Professional Land Surveyor - 2093

Survey Date: July 8, 2021.
Revisions: No. 1 - Proposed Addition
No. 2 - Foundation

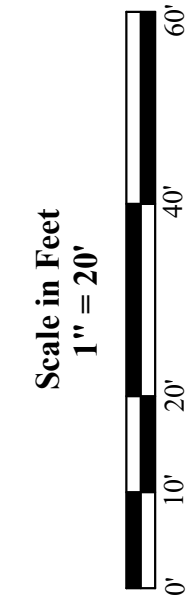

45 South Wisconsin Street | P.O. Box 322
Elkhorn, Wisconsin. 53121
Telephone: (262) 723-3434
Facsimile: (262) 723-8044
Email: doug@olsonsurveying.com
Website: www.olsonsurveying.com

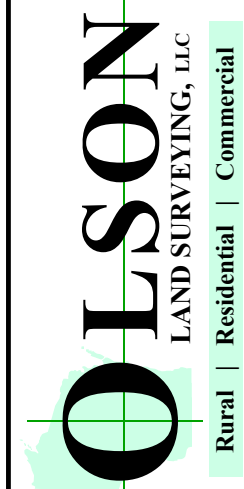

Legend of Symbols & Abbreviations	
Found County Section Corner	N North S South E East W West
Found Iron Pipe	in Degrees
Found Iron Rod	in Feet
Set Iron Pipe, 1" dia.	in Feet
Electric Transformer	in Feet
Utility Pole	in Feet
Manhole	in Feet
Water Valve	in Feet
Asphalt Surface	in Feet
Gravel Surface	in Feet
Brick Pavers	in Feet

Sheet 1 of 1 Sheets
Drawing Name
Job Reference Number
2021.064

2021.064