
Lot 8, Block 2, in McKenna's Addition according to the Plat of said Addition of record in the Office of the Register of Deeds in and for Walworth County, Wisconsin, in Vol. 12 of Plats at Page 1.

SURVEY FOR: Great American Funding Corp.

BUYER: Steven J. Thomas

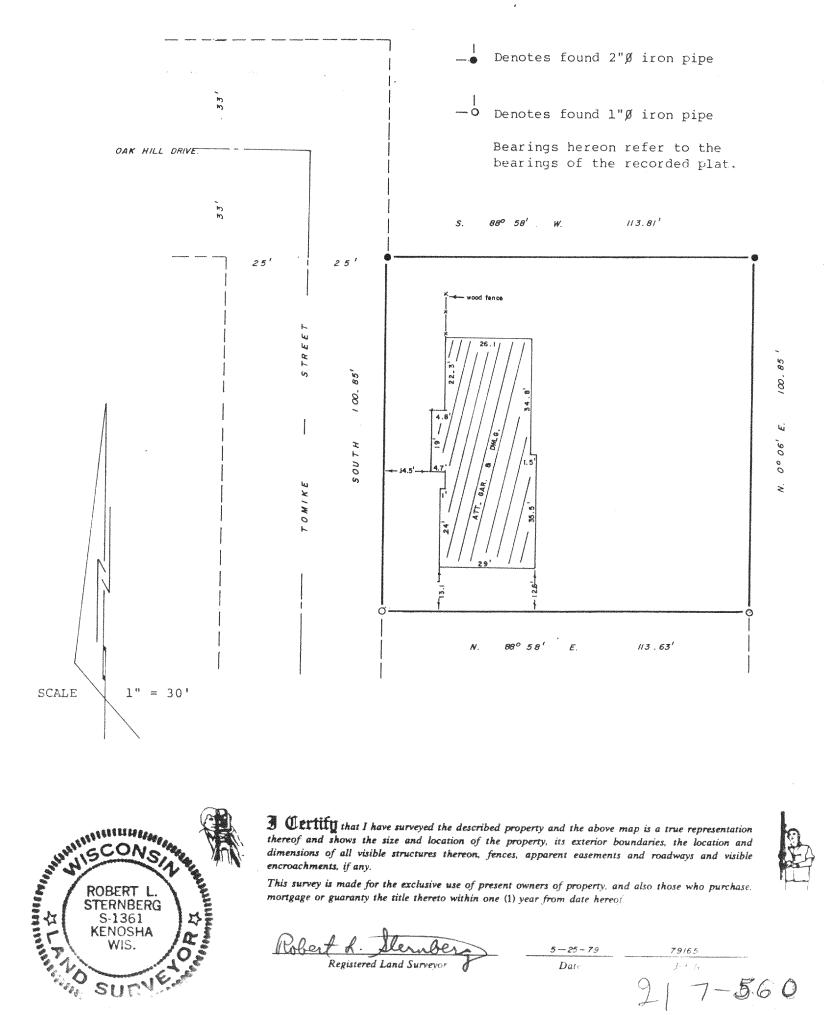

I Certify that I have surveyed the described property and the above map is a true representation thereof and shows the size and location of the property, its exterior boundaries, the location and dimensions of all visible structures thereon, fences, apparent easements and roadways and visible encroachments, if any.

This survey is made for the exclusive use of present owners of property, and also those who purchase. mortgage or guaranty the title thereto within one (1) year from date hereof.

5-25-79 Date

7-560