
## KOLB LAND CONSULTING, INC.

LAND SURVEYING . SUBDIVIDING . LAND PLANNING

LAKE GENEVA, WISCONSIN 53147

WHITEWATER, WISCONSIN 53190



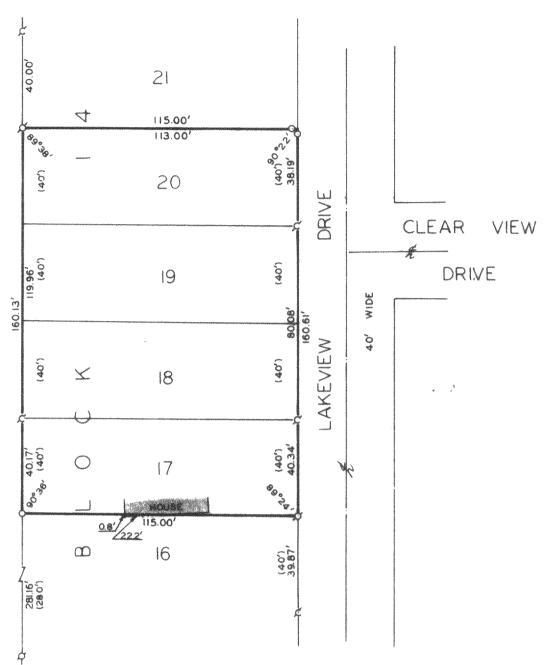



L E G E N D SCALE: 1 \*\* = 40 \*

Ø - IRON PIPE FOUND

O - IRON PIPE PLACED

C - POSEY PIN FOUND

() - RECORDED AS

## PLAT OF SURVEY OF

LOTS 17-20, BLOCK 14, SUNSET HILLS, A SUBDIVISION LOCATED IN TOWN 2 NORTH, RANGE 17 EAST, WALWORTH COUNTY, WISCONSIN.

OWNER: ALBERT D'ANNA
ORDERED BY: STURGE TAGGART AGENCY
LAKE GENEVA, 'VI 53147

I, HAROLD.H. KOLB, DO HEREBY CERTIFY THAT I HAVE SURVEYED THE PROPERTY HEREON DESCRIBED ACCORDING TO THE OFFICIAL RECORDS, AND THAT THE PLAT HEREON IS A CORRECT REPRESENTATION OF THE LOT LINES TO THE BEST OF MY KNOWLEDGE AND BELIEF.

HAROLD H. KOLB WISCONSIN REGISTERED LAND SURVEYOR, S-187