


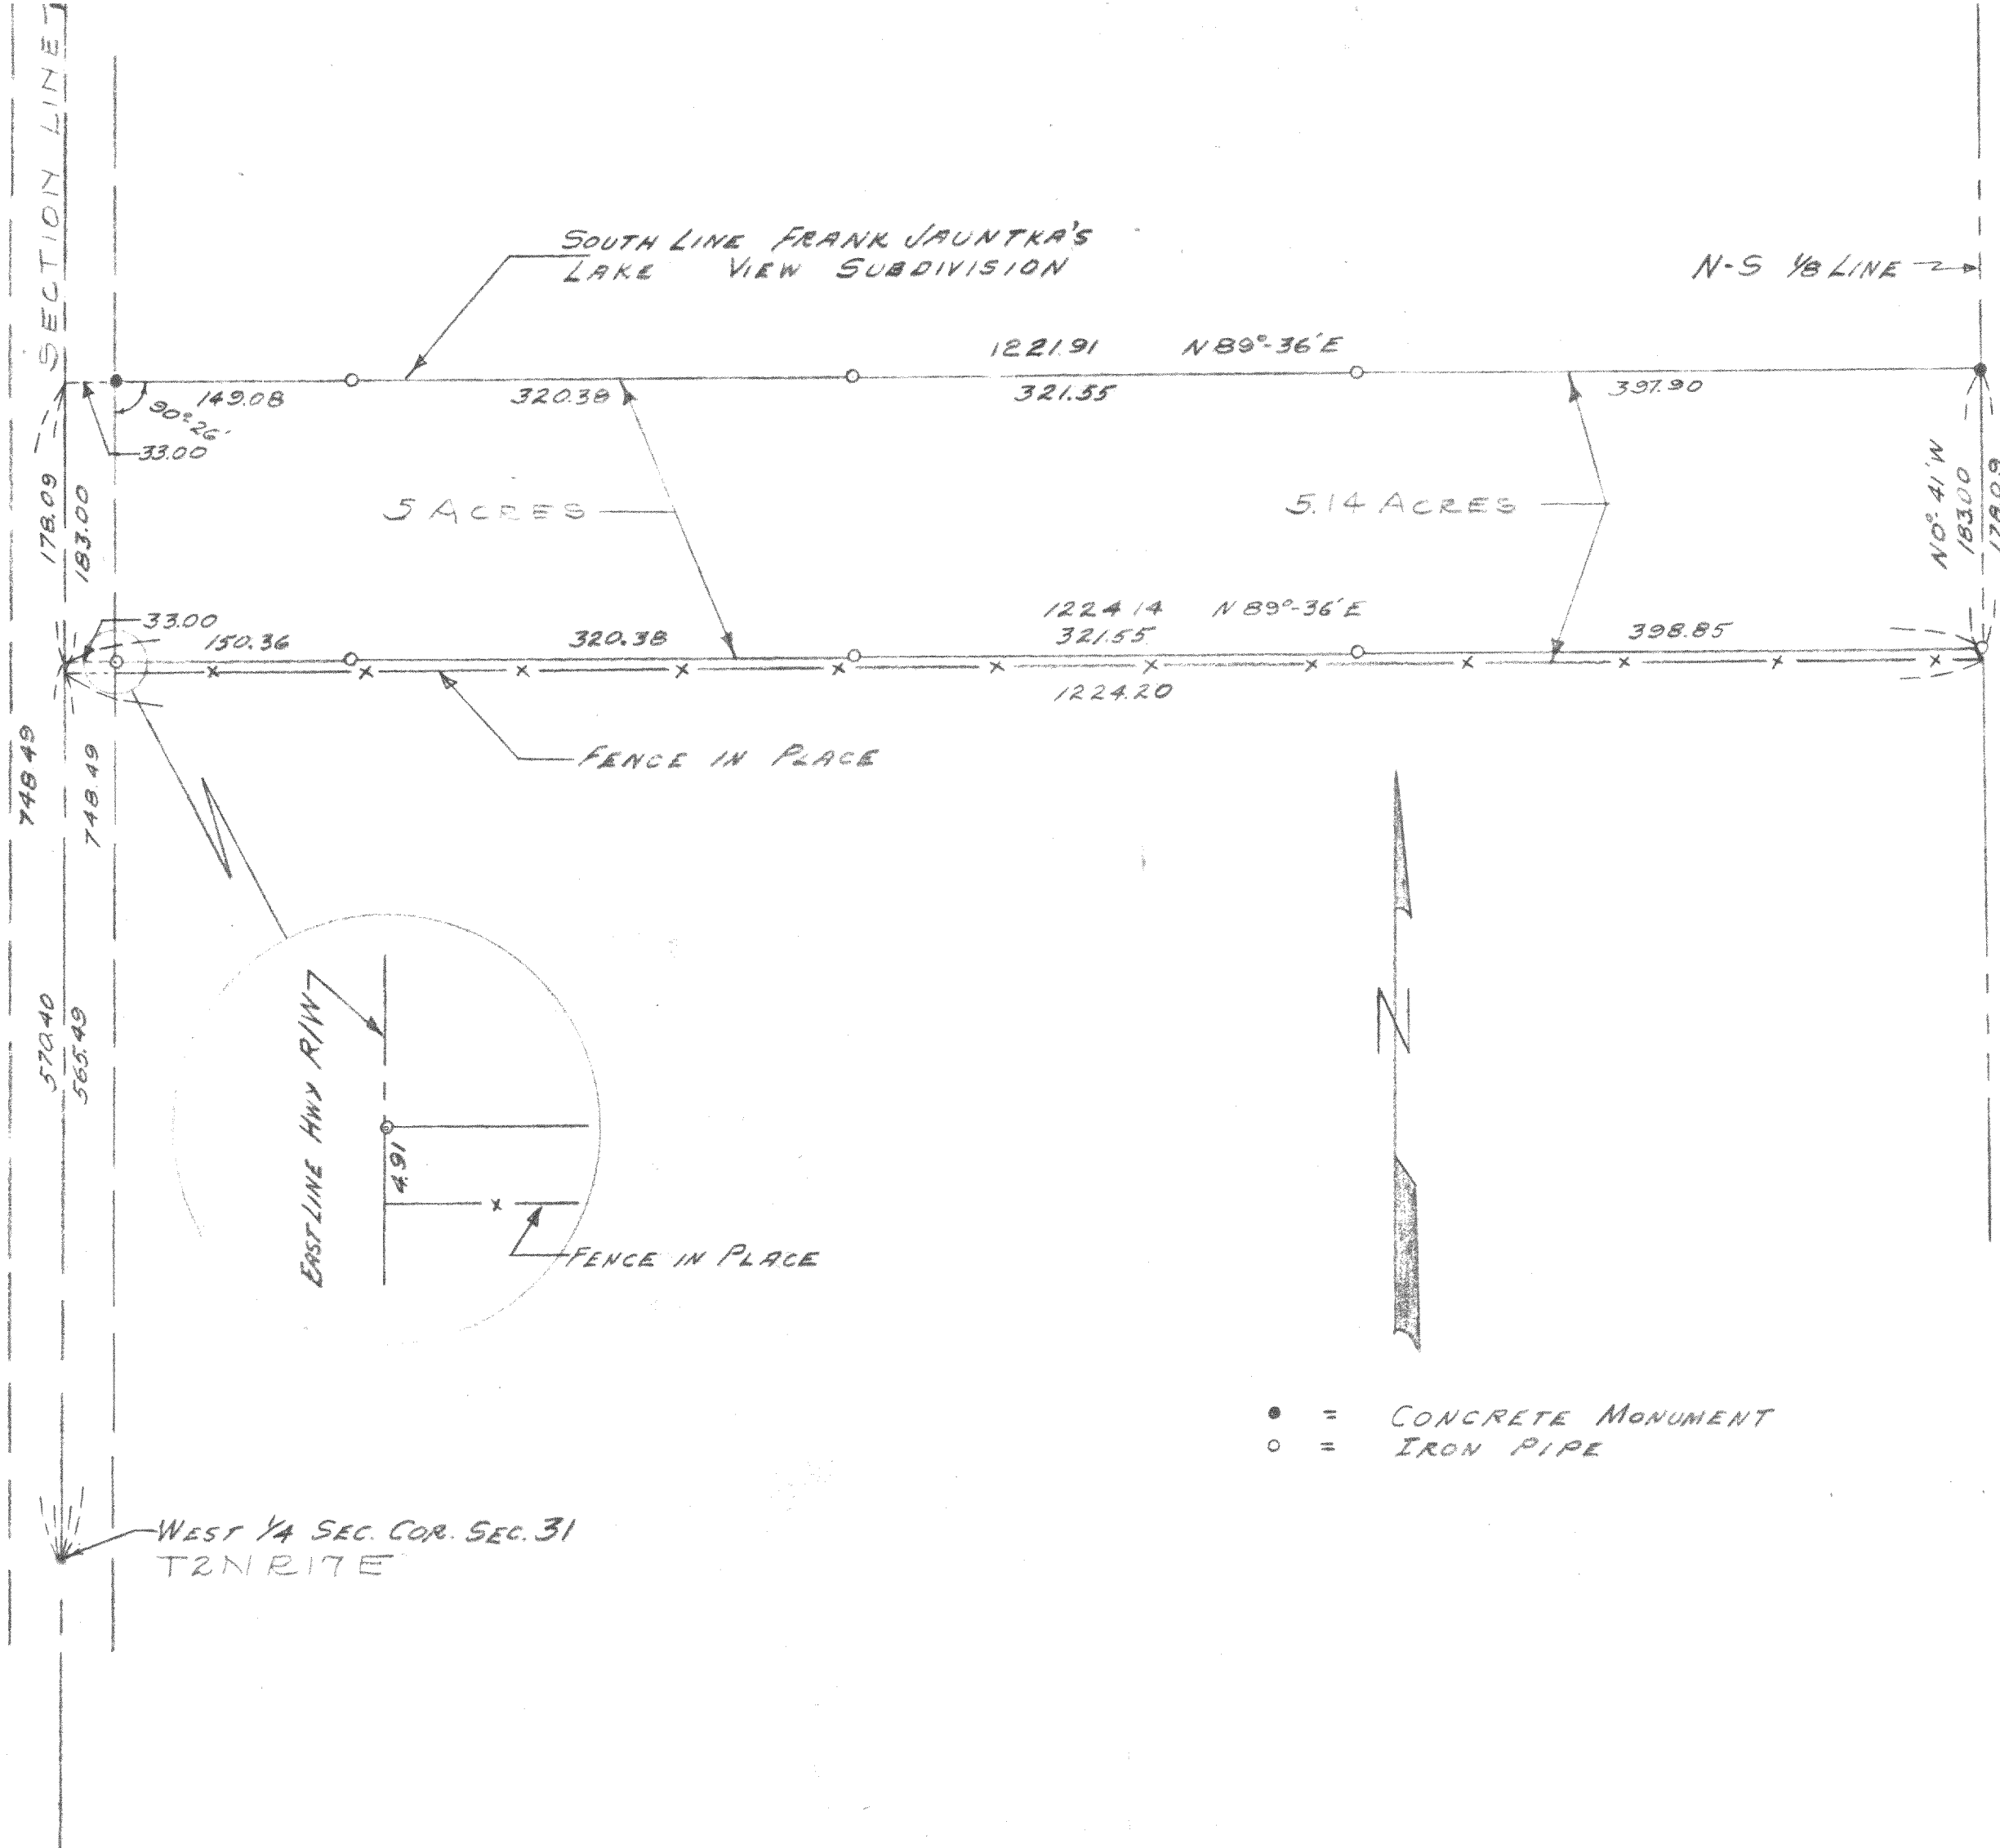

G-31-3

217-58.5

PLAT OF SURVEY OF LAND LOCATED IN THE NW 1/4 OF SECTION 31, T2N R17E OF WALWORTH COUNTY, WISCONSIN.	
<i>Lloyd L. Jensen</i> SURVEYOR	DATE <u>MAY 1953</u>
SCALE 1" = 100'	