


DRAWING NUMBER 2187

PLAT OF SURVEY OF LOTS 5576 - 5578 of BLOCK 100 of
LAKE COMO BEACH SUBDIVISION LOCATED IN TOWN 2 NORTH, RANGE 1 EAST,
WALWORTH COUNTY, WISCONSIN
For Mikrut Realty

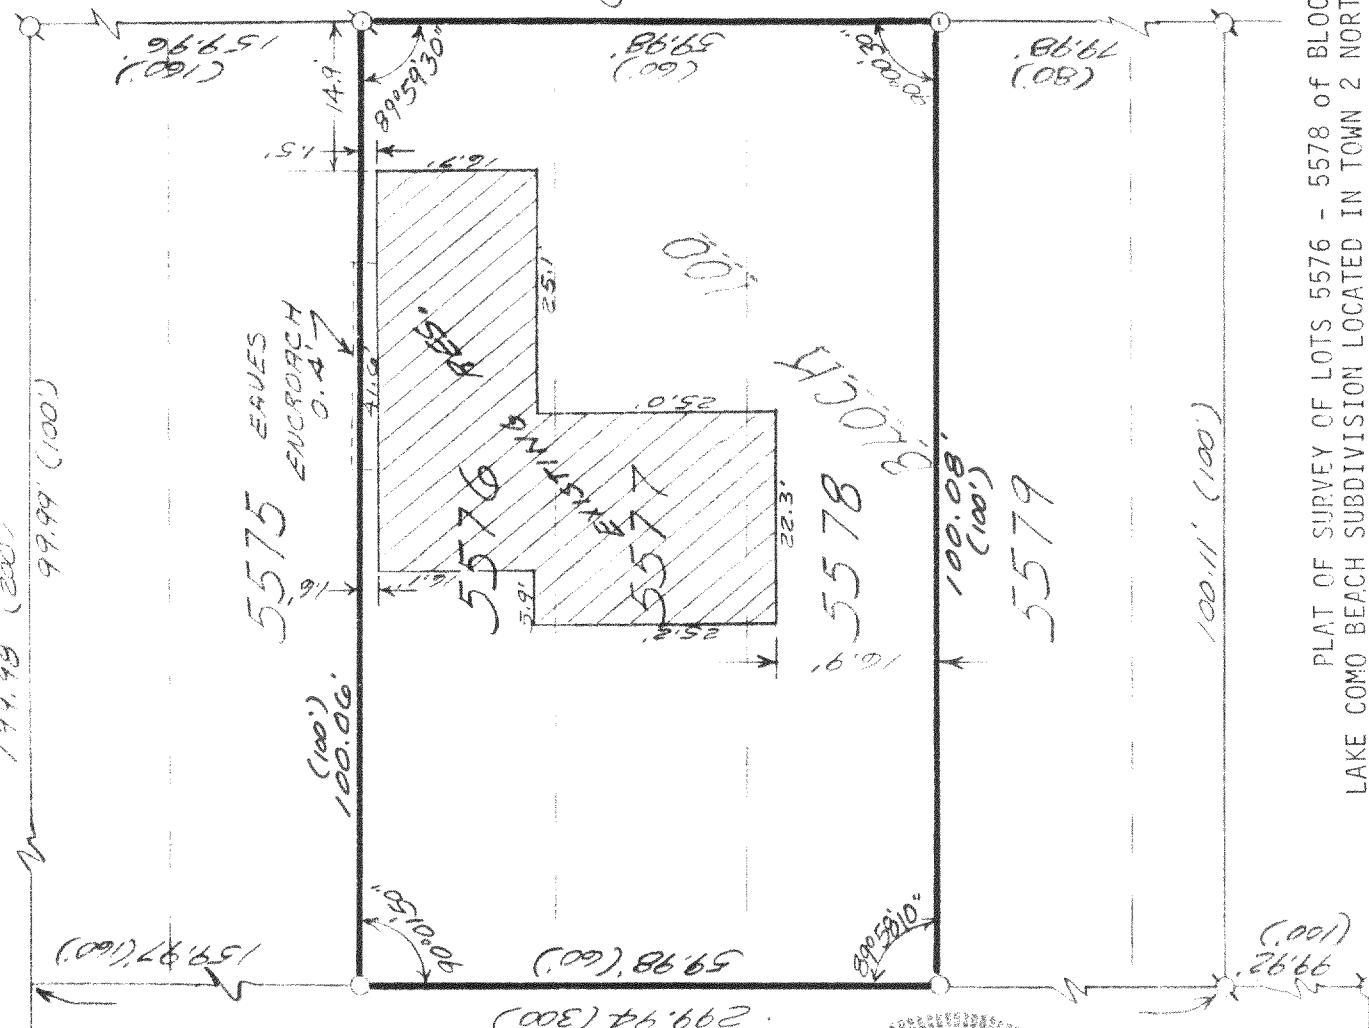

I hereby certify that I have surveyed the above described property and that the above map is a true representation thereof and shows the size and location of the property, its exterior boundaries, the location of all visible structures and dimensions of all principal buildings thereon, boundary fences, apparent easements, roadways and visible encroachments, if any.

This survey is made for the use of the present owners of the property, and also those who purchase, mortgage, or guarantee the title thereto within one (1) year from date hereof.

Robert A. Farris RLS
Dated this 25th day of November, 1983

FARRIS, HANSEN & ASSOCIATES, INC.
715 W. Walworth St. P.O. Box 487
Elkhorn, WI 53121

JLCB-1134

217-588-F