


KOLB LAND CONSULTING, INC.  
 LAND SURVEYING · SUBDIVIDING · LAND PLANNING


LAKE GENEVA, WISCONSIN 53147

WHITEWATER, WISCONSIN 53190

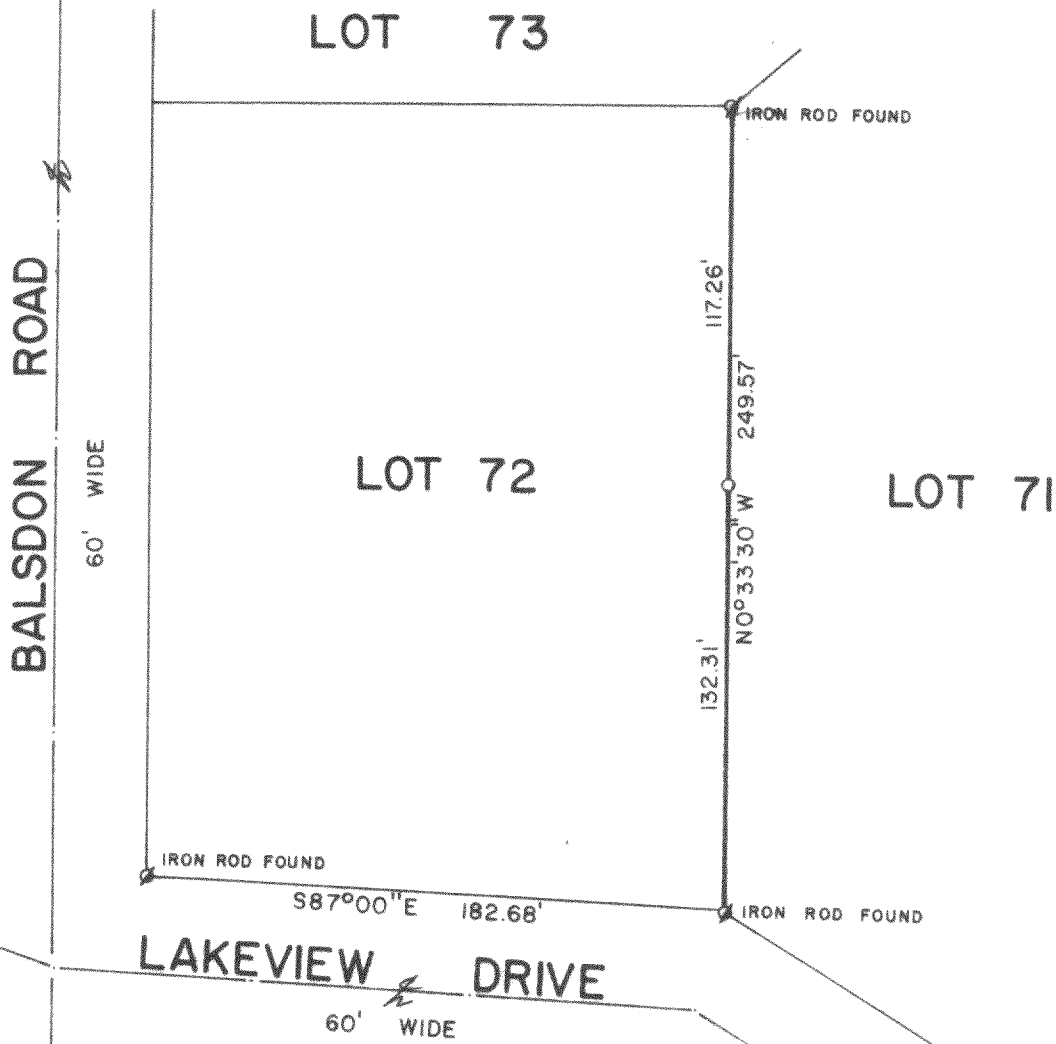

PLAT OF SURVEY OF  
 THE EAST LINE OF LOT 72 OF WILDWOOD ADDITION  
 NO. ONE, LOCATED IN SECTION 34, T 2 N, R 17 E  
 WALWORTH COUNTY, WISCONSIN.

ORDERED BY: RICHARD BRUGGER  
 721 GENEVA STREET  
 LAKE GENEVA, WISCONSIN 53147

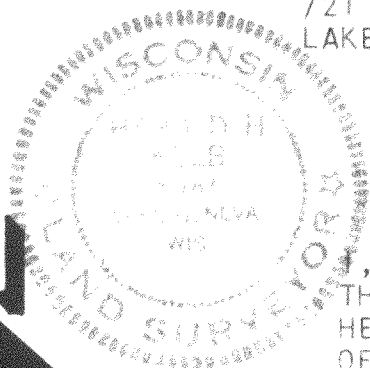

HAROLD H. KOLB, DO HEREBY CERTIFY  
 THAT I HAVE SURVEYED THE PROPERTY  
 HEREON DESCRIBED ACCORDING TO THE  
 OFFICIAL RECORDS; AND THAT THE PLAT  
 HEREON IS A CORRECT REPRESENTATION  
 OF THE LOT LINES TO THE BEST OF MY  
 KNOWLEDGE AND BELIEF.

SCALE: 1"=60'

o - IRON PIPE PLACED

*Harold H. Kolb*  
 HAROLD H. KOLB  
 WISCONSIN, REGISTERED LAND SURVEYOR, S- 187  
 DATE July 23, 1982