

**PLAT OF SURVEY
OF**

LOTS 7547 THRU 7555, BLOCK 129, LAKE COMO BEACH SUB., LOCATED IN SECTION 28, T. 2 N., R. 17 E
TOWNSHIP OF GENEVA, COUNTY OF WALWORTH, STATE OF WISCONSIN.

FOR: STELLA MALINOVSKY


SCALE 1" = 30'

 = IRON PIPE STANCH FOND.

• = IRON PIPE STARS SET.

THIS SURVEY IS A REVISION OF A
PREVIOUS SURVEY OF SAME LOTS,
FILED WITH WALWORTH COUNTY
SURVEY OFFICE AS NO. 217-565

PLATTED (ERRONEOUS) LOT
NUMBERS IN PARENTHESES.

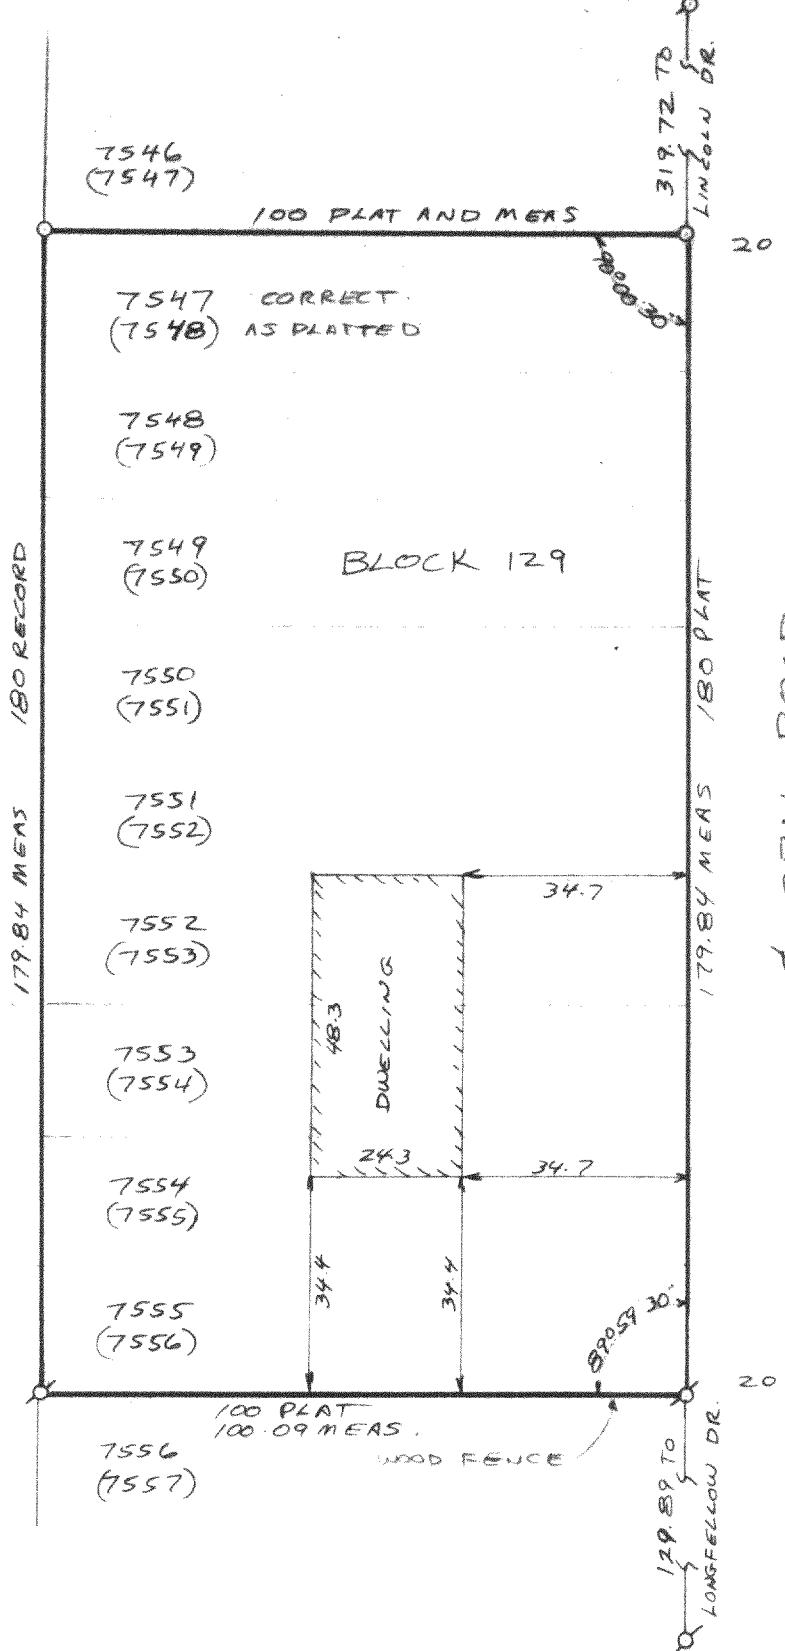

THE RECORDED PLAT OF LAKE COMO BEACH SUB.,
OMITS LOT NO. 7545 IN BLOCK 129 AND SHOWS
LOT NO. 7558 TWICE. IN ORDER TO RECONCILE
OWNERSHIP WITH OCCUPATIONAL EVIDENCE,
LOT NO. 7545 MUST BE USED IN ITS PROPER
LOCATION ALONG OPAL ROAD.

I have surveyed the above-described property, and the map hereon is a true representation thereof and shows the size and location of the property, its exterior boundaries, the location and dimensions of all visible structures thereon, fences, apparent easements and roadways and visible encroachments, if any.

This survey is made for the exclusive use of the present owners of the property, and also those who purchase, mortgage, or guarantee the title thereto, within one year from date hereof,

Dated at Burlington, this 5th day
of ~~OCTOBER~~, 1884.

John F. Degen
John F. Degen, Land Surveyor S 242

