ABERNATHY and ASSOCIATES

Kenneth B. Abernathy Jr.

Wisconsin Registered Land Surveyor

5-1594

Rt. 3, Box 273 Elkhorn, Wisconsin 53121 Phone: (414) 723-4260 (office)

(414) 723-4813 (residence)

PLAT OF SURVEY

Lots 39,40,41, and 42 of GUMMOW ADDITION, a subdivision located in the Northwest $\frac{1}{4}$ of Section 25, T. 2 N., R. 17 E., Walworth County, Wisconsin. Also the West 5 feet of a 10 feet wide Alley adjoining said Lots.

Ordered By: Universal Mortgage


744 N. Mayfair Rd.

Milwaukee, WI. 53203

Owner: Forbes J. Giles

Rt. 5 Box 1098

Lake Geneva, WI. 53147

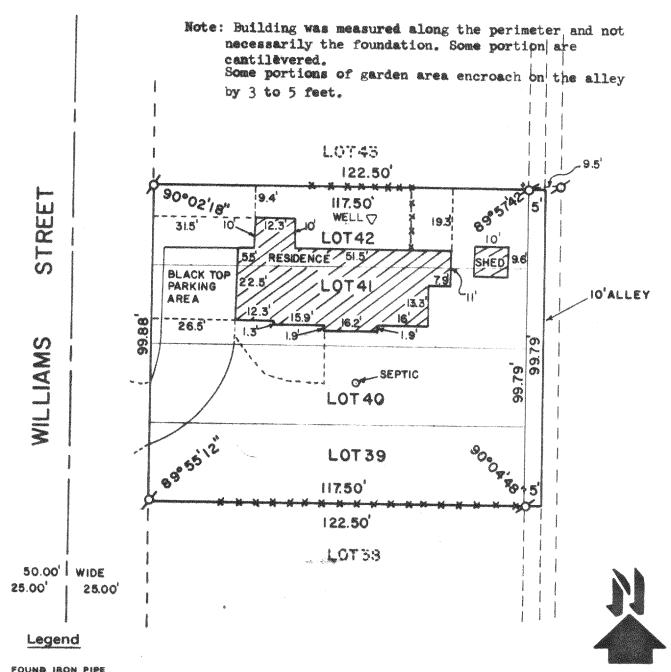

FOUND IRON PIPE

FOUND IRON ROD

(xx)

FOUND BRASS CAPPED MONUMENT

FOUND CONCRETE MONUMENT

CHISEL CUT IN CONCRETE

SET IRON ROD, 24" LONG, WEIGHING 1.5 LBS./LINEAL PT., 3/4" DIA.

SET IRON ROD, 38" LONG, WEIGHING 4.5 LBS./LINEAL FT., 1-11/16" DIA.

SCALE: 1"= 30 FEET

"I hereby certify that I have surveyed the above described property and that the above map is a true representation thereof and shows the size and location of the property, its exterior boundaries, the location of all visible structures and dimensions of all principal buildings thereon, boundary fences, apparent easements, roadways and visible encroachments if any "

end dimensions of all principal buildings thereon, boundary fences, apparent easements, roadways and visible encroachments, if any."

"This survey is made for the use of the present owners of the property, and also those who purchase, mortgage, or guarantee the title thereto within one year from date hereof."

RECORDED AS DIMENSION ECEIVE APR 1 4 1986

KENNETH B. ABERNATHY, JR. WISCONSIN REGISTERED LAND SURVEYOR,

S-1594

Date: 4/7/86 Job No. 402