


ABELL
SURVEYING & MAPPING
DELAVER, WISCONSIN 53115
414-728-6737

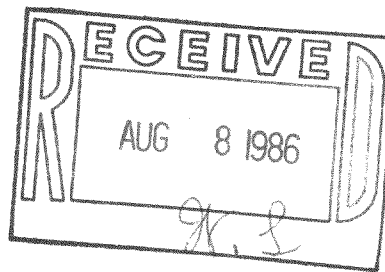

WHITTIER DRIVE

NW CORNER
BLOCK 199

(N 89°39'56"W 440') 439.44'

99.86' (100')


199.92' (200')

199.87' (200')

PLAT OF SURVEY OF

LOTS 10673-10677, BLOCK 193, LAKE
COMO BEACH SUBDIVISION, T2N, R17E,
WALWORTH COUNTY, WISCONSIN.

ORDERED BY: THE RAULAND AGENCY
607 E. WALWORTH AVE.
DELAVER, WI. 53115

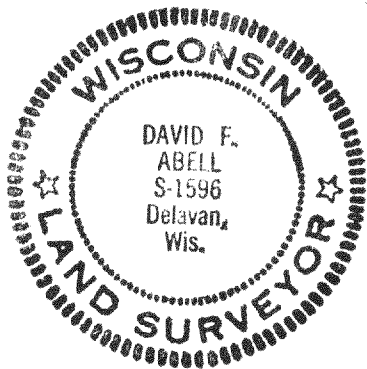

BLOCK

ROAD

URANUS

4.0'

SW CORNER
BLOCK 199

SE CORNER
BLOCK 199

SW CORNER
BLOCK 193

200.30'

(200')

39.87' (40')

99.86' (100')

99.86' (100')

HEMLOCK DRIVE

DRIVE

LAKE SHORE DRIVE



SCALE - 1"=40'

LEGEND

- ⊙ - IRON PIPE FOUND
- - 3/4" IRON ROD SET
- () - RECORDED AS
- Δ - UTILITY POLE
- - OVERHEAD UTILITY LINE

I HEREBY CERTIFY THAT I HAVE SURVEYED THE
ABOVE DESCRIBED PROPERTY AND THAT THE ABOVE
MAP IS A TRUE REPRESENTATION THEREOF AND
SHOWS THE SIZE AND LOCATION OF THE PROPERTY,
ITS EXTERIOR BOUNDARIES, THE LOCATION OF ALL
PRINCIPAL BUILDINGS THEREON, BOUNDARY FENCES,
APPARENT EASEMENTS, ROADWAYS, AND VISIBLE
ENCROACHMENTS, IF ANY, TO THE BEST OF MY
KNOWLEDGE AND BELIEF.

THIS SURVEY IS MADE FOR THE USE OF THE
PRESENT OWNERS OF THE PROPERTY, AND ALSO
THOSE WHO PURCHASE, MORTGAGE, OR GUARANTEE
THE TITLE THERETO WITHIN ONE (1) YEAR FROM
DATE HEREOF.

David F. Abell

DAVID F. ABELL

WISCONSIN REGISTERED LAND SURVEYOR, S-1596

DATE *July 2, 1986*

JOB NUMBER - 86022

JLCB-02318

217-637