
WALWORTH COUNTY SURVEYING & MAPPING LAKE GENEVA, WISCONSIN

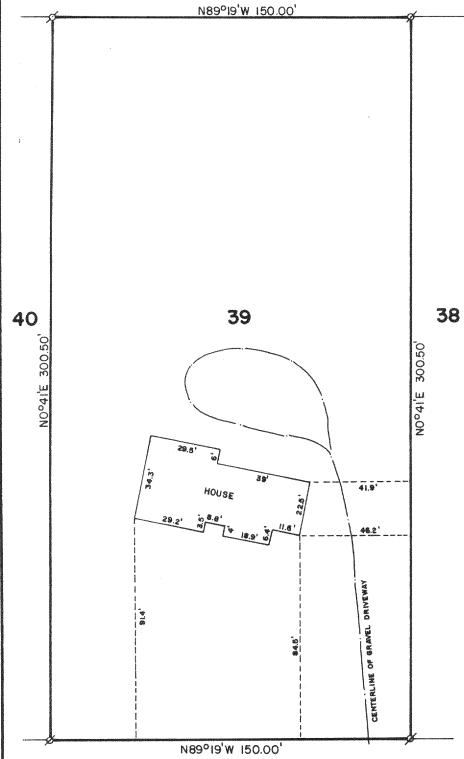

PLAT OF SURVEY OF

LOT 39 OF WILDWOOD SUBDIVISION, LOCATED IN SECTION 34, T 2 N, R 17 E, WALWORTH COUNTY, WISCONSIN.

ORDERED BY: REALTY WORLD-TAGGART

736 MAIN STREET

LAKE GENEVA, WISCONSIN

53147

WILDWOOD DRIVE



SCALE: 1"=40'

p - IRON FIPE FOUND ø IRO ROD FARD



I, ROBERT M. BAERENWALD, DO HEREBY CERTIFY THAT I HAVE SURVEYED THE PROPERTY HEREON DESCRIBED ACCORDING TO THE OFFICIAL RECORDS AND THAT THE PLAT HEREON IS A CORRECT REPRESENTATION OF THE PROPERTY LINES TO THE BEST OF MY KNOWLEDGE AND BELLEF.

ROBERT M. BAERENWALD

WISCONSIN REGISTERED LAND SURVEYOR, S-1508

DATE **JOB NO.** 0820

NOTE: THIS IS NOT A CERTIFIED COPY UNLESS SEALED.