
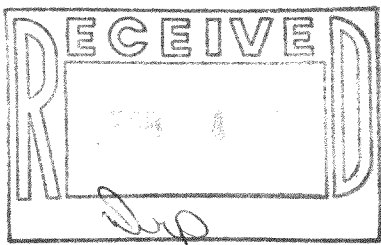


WALWORTH COUNTY
SURVEYING & MAPPING
LAKE GENEVA, WISCONSIN


WILLOW BEND LANE

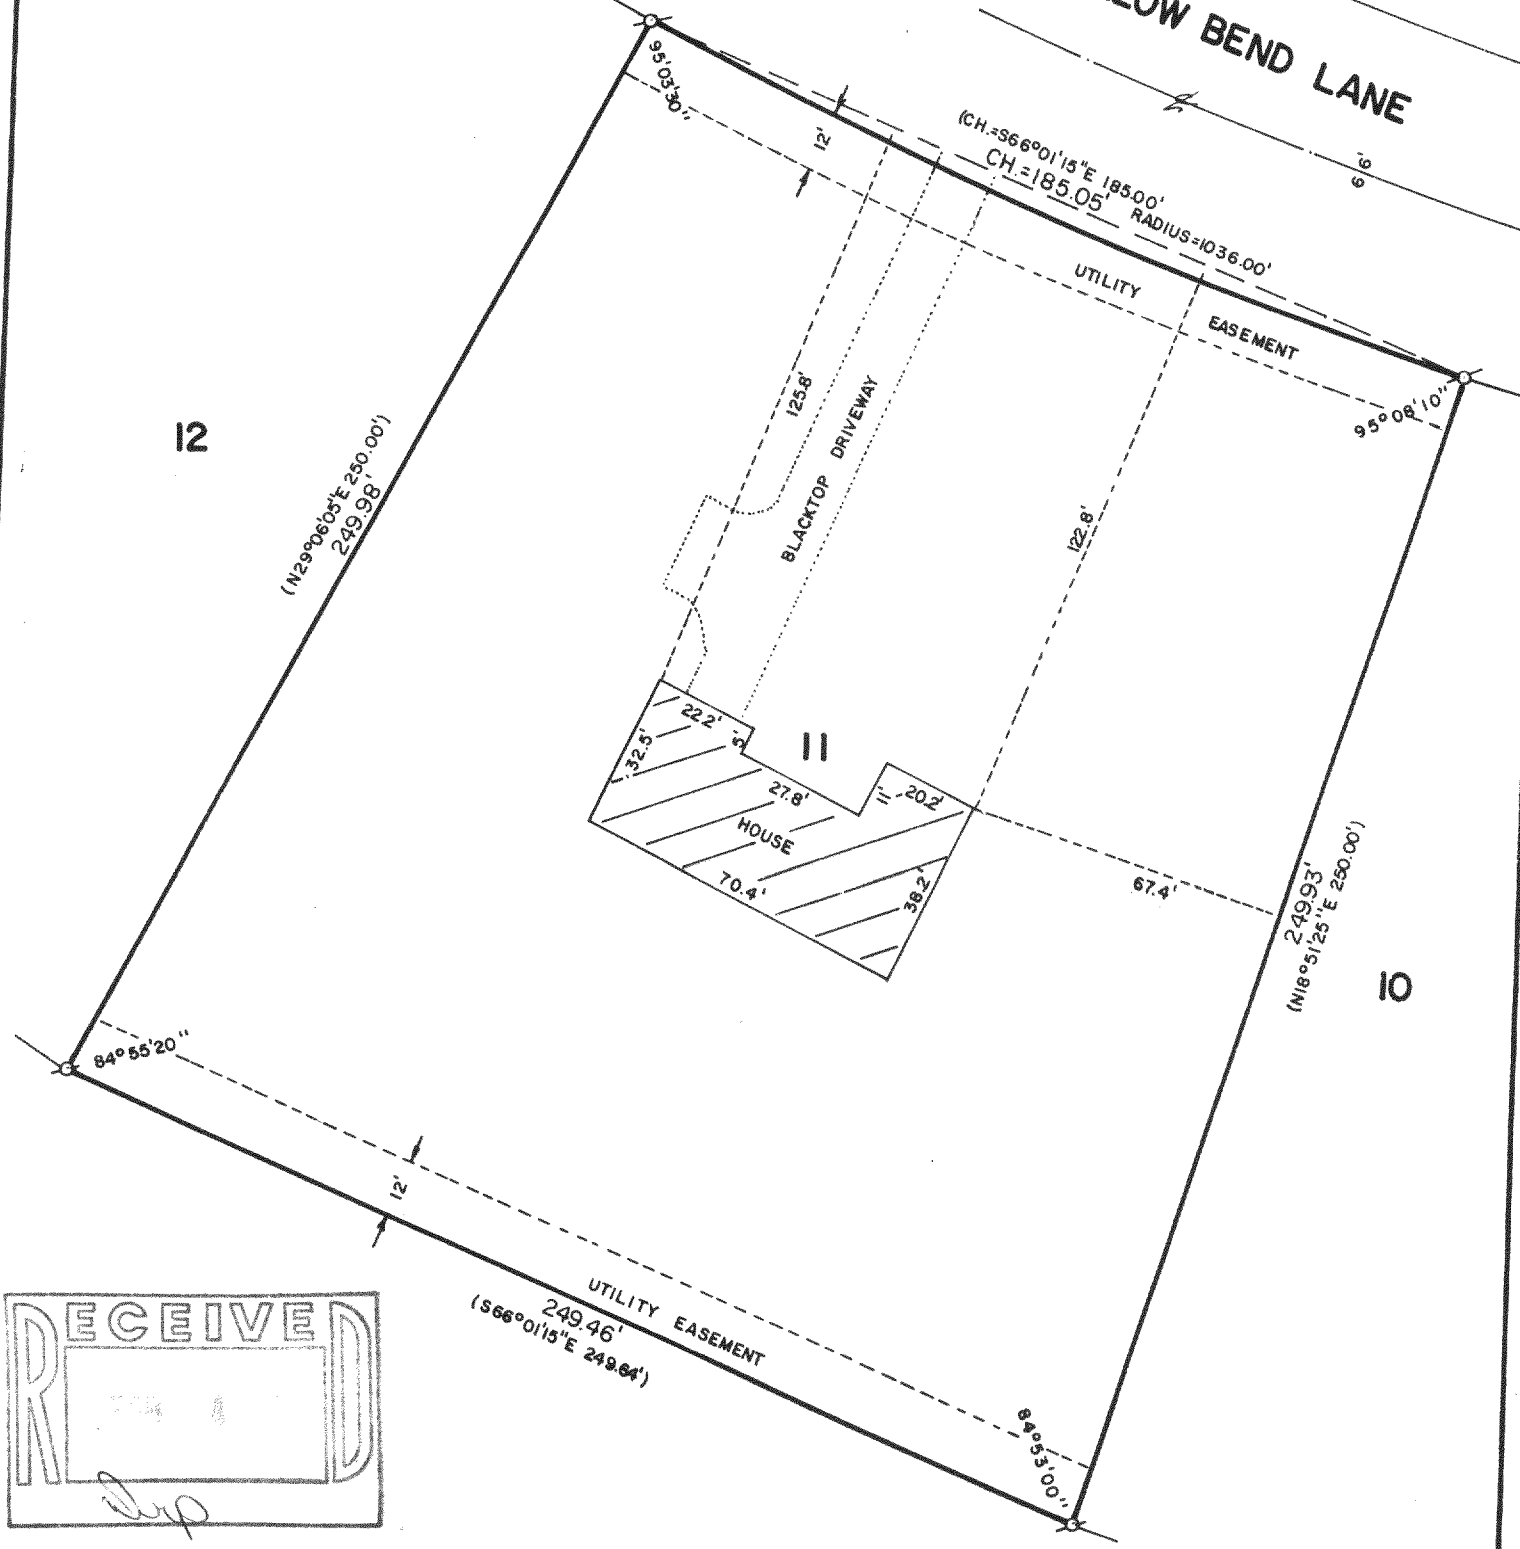

PLAT OF SURVEY OF

LOT 11 OF WILLOW BEND PARK, A SUBDIVISION LOCATED
IN SECTIONS 15 AND 22, T 2 N, R 17 E, WALWORTH
COUNTY, WISCONSIN.

ORDERED BY: UNIVERSAL MORTGAGE
3416 ROOSEVELT ROAD
KENOSHA, WISCONSIN 53142

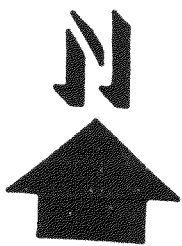

SCALE: 1"=40'

Ø - IRON PIPE FOUND
() - RECORDED AS

I, ROBERT M. BAERENWALD, DO HEREBY CERTIFY THAT I
HAVE SURVEYED THE PROPERTY HEREON DESCRIBED ACCORDING
TO THE OFFICIAL RECORDS AND THAT THE PLAT HEREON IS A
CORRECT REPRESENTATION OF THE PROPERTY LINES TO THE
BEST OF MY KNOWLEDGE AND BELIEF.

Robert M. Baerenwald
ROBERT M. BAERENWALD
WISCONSIN REGISTERED LAND SURVEYOR, S-1508

Dec. 25, 1986
DATE JOB NO. 0882

NOTE: THIS IS NOT A CERTIFIED COPY UNLESS SEALED.