



WALWORTH COUNTY
SURVEYING & MAPPING
LAKE GENEVA, WISCONSIN

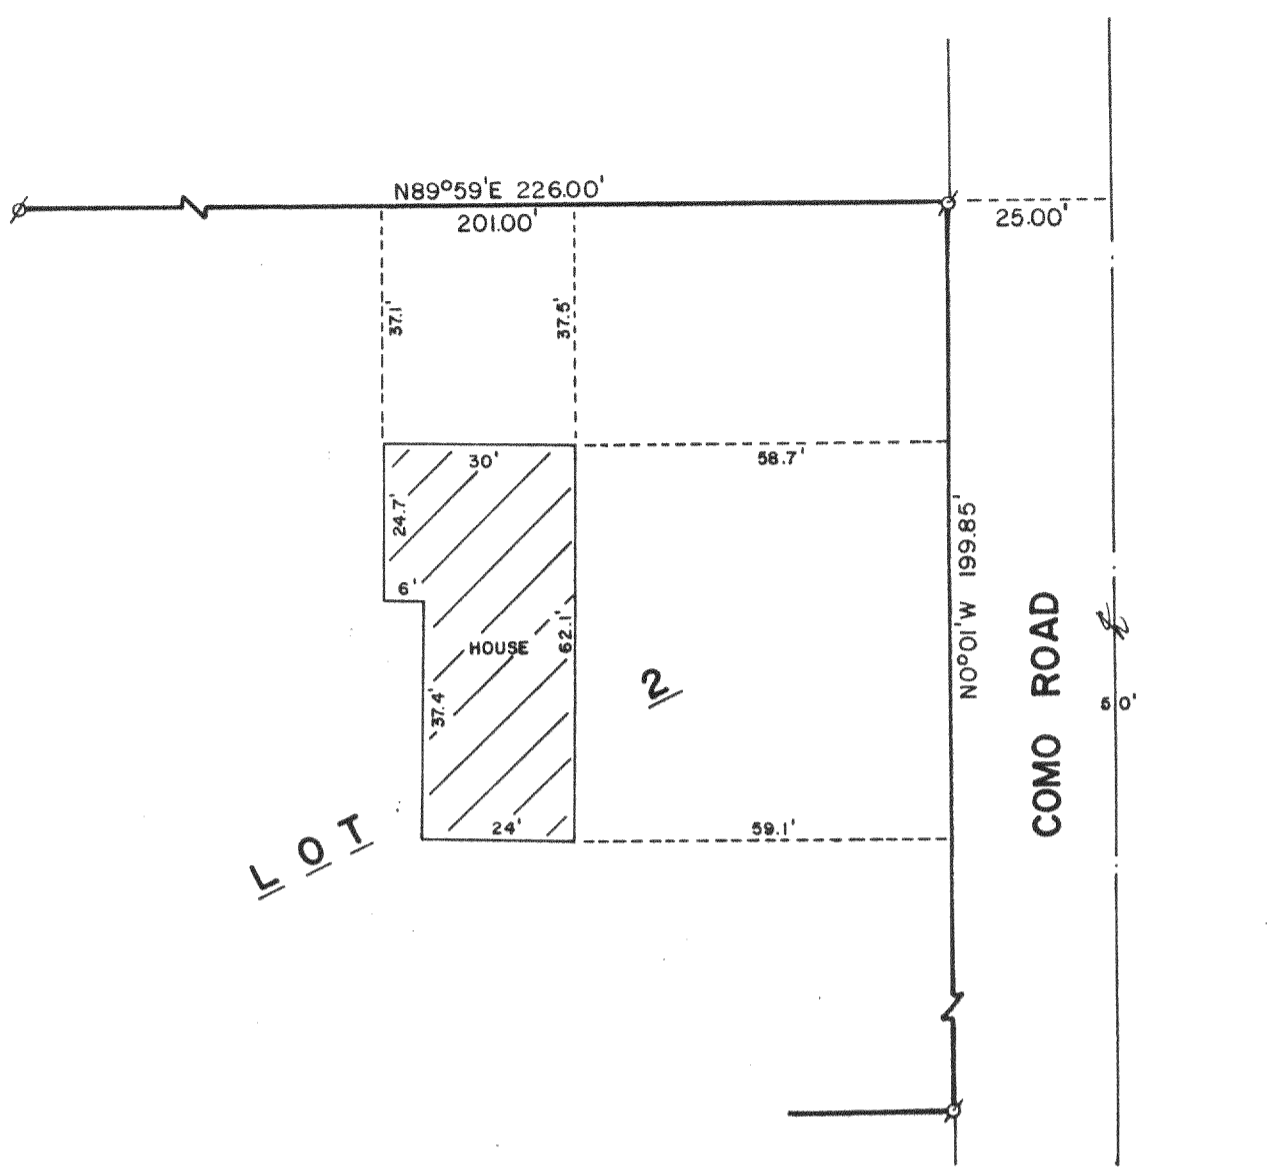


PLAT OF SURVEY OF

A HOUSE UNDER CONSTRUCTION ON LOT 2 OF
CERTIFIED SURVEY MAP NO. 1556, LOCATED
IN SECTION 21, T 2 N, R 17 E, WALWORTH
COUNTY, WISCONSIN.

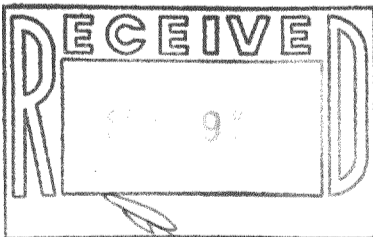

ORDERED BY: TOM BORGEN
1217 DODGE STREET
LAKE GENEVA, WISCONSIN
53147

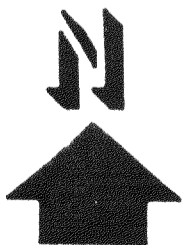

SCALE: 1"=30'

⊘ - IRON PIPE FOUND
⊘ - IRON ROD FOUND

I, ROBERT M. BAERENWALD, DO HEREBY CERTIFY THAT I
HAVE SURVEYED THE PROPERTY HEREON DESCRIBED ACCORDING
TO THE OFFICIAL RECORDS AND THAT THE PLAT HEREON IS A
CORRECT REPRESENTATION OF THE PROPERTY LINES TO THE
BEST OF MY KNOWLEDGE AND BELIEF.

Robert M. Baerenwald
ROBERT M. BAERENWALD
WISCONSIN REGISTERED LAND SURVEYOR, S-1508

Aug. 24, 1987
DATE JOB NO. 0810

NOTE: THIS IS NOT A CERTIFIED COPY UNLESS SEALED.