


KOLB LAND CONSULTING, INC.  
LAND SURVEYING • SUBDIVIDING • LAND PLANNING

929 WILLIAMS STREET LAKE GENEVA, WISCONSIN 53147 414-248-3697

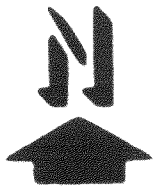

SCALE: 1" = 50'

LEGEND

- ⊙ - IRON PIPE FOUND
- ⦿ - IRON ROD FOUND
- G - GARAGE

NOTE: BEARINGS ARE ASSUMED AS SHOWN ON THE RECORDED PLAT OF WILDWOOD SUBDIVISION.

LOT 15


LOT 16

LOT 17

PLAT OF SURVEY OF

LOT 16, WILDWOOD SUBDIVISION,  
LOCATED IN THE NORTHWEST 1/4  
AND THE NORTHEAST 1/4 OF SECTION  
34, T2N, R17E, TOWN OF GENEVA,  
WALWORTH COUNTY, WISCONSIN.

ORDERED BY: MRS. JOAN OLSON  
RT. 4 BOX 980  
LAKE GENEVA, WI. 53147

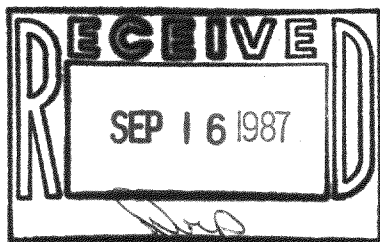

I HEREBY CERTIFY THAT I HAVE SURVEYED THE ABOVE DESCRIBED PROPERTY AND THAT THE ABOVE MAP IS A TRUE REPRESENTATION THEREOF AND SHOWS THE SIZE AND LOCATION OF THE PROPERTY, ITS EXTERIOR BOUNDARIES, THE LOCATION OF ALL VISIBLE STRUCTURES AND DIMENSIONS OF ALL PRINCIPAL BUILDINGS THEREON, BOUNDARY FENCES, APPARENT EASEMENTS, ROADWAYS AND VISIBLE ENCROACHMENTS, IF ANY, TO THE BEST OF MY KNOWLEDGE AND BELIEF.  
THIS SURVEY IS MADE FOR THE USE OF THE PRESENT OWNERS OF THE PROPERTY AND ALSO THOSE WHO PURCHASE, MORTGAGE OR GUARANTEE THE TITLE THERETO WITHIN ONE (1) YEAR FROM DATE HEREOF.

SURVEY NOT VALID UNLESS SURVEYOR'S SIGNATURE IS IN RED.

HAROLD H. KOLB

WISCONSIN REGISTERED LAND SURVEYOR, S-187

DATE JUNE 5, 1987

REVISED

REVISED

JWS-16

2-17-315

217-714