
WALWORTH COUNTY SURVEYING & MAPPING LAKE GENEVA, WISCONSIN

## WOODLAND DRIVE

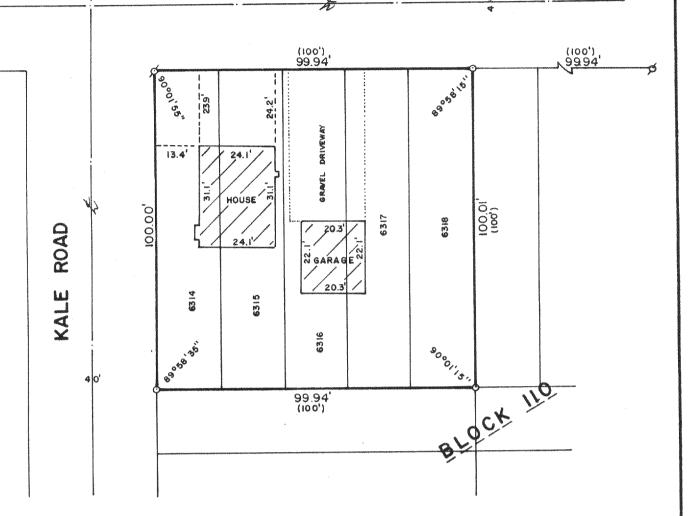

6314 PLAT OF SURVEY OF

LOTS 6318-6318, BLOCK 110 OF LAKE COMO BEACH, A SUBDIVISION LOCATED IN T 2 N, R 17 E, WALWORTH COUNTY, WISCONSIN.



ORDERED BY: MIKRUT REALTY

RT. 5, BOX 453 LAKE GENEVA, WISCONSIN

53147



SCALE: 1"=30'

ø -IRON PIPE FOUND o -IRON PIPE PLACED ()-RECORDED AS I, ROBERT M. BAERENWALD, DO HEREBY CERTIFY THAT I HAVE SURVEYED THE PROPERTY HEREON DESCRIBED ACCORDING TO THE OFFICIAL RECORDS AND THAT THE PLAT HEREON IS A CORRECT REPRESENTATION OF THE PROPERTY LINES TO THE BEST OF MY KNOWLEDGE AND BELIEF.

ROBERT M. BAERENWALD

WISCONSIN REGISTERED LAND SURVEYOR, S-1508

DATE JOB NO. 1211

NOTE: THIS IS NOT A CERTIFIED COPY UNLESS SEALED.

JLCB-1309