


DUNHAM SURVEYING, S.C.
 SURVEYING & SUBDIVIDING
 DELAVAN, WISCONSIN 53115

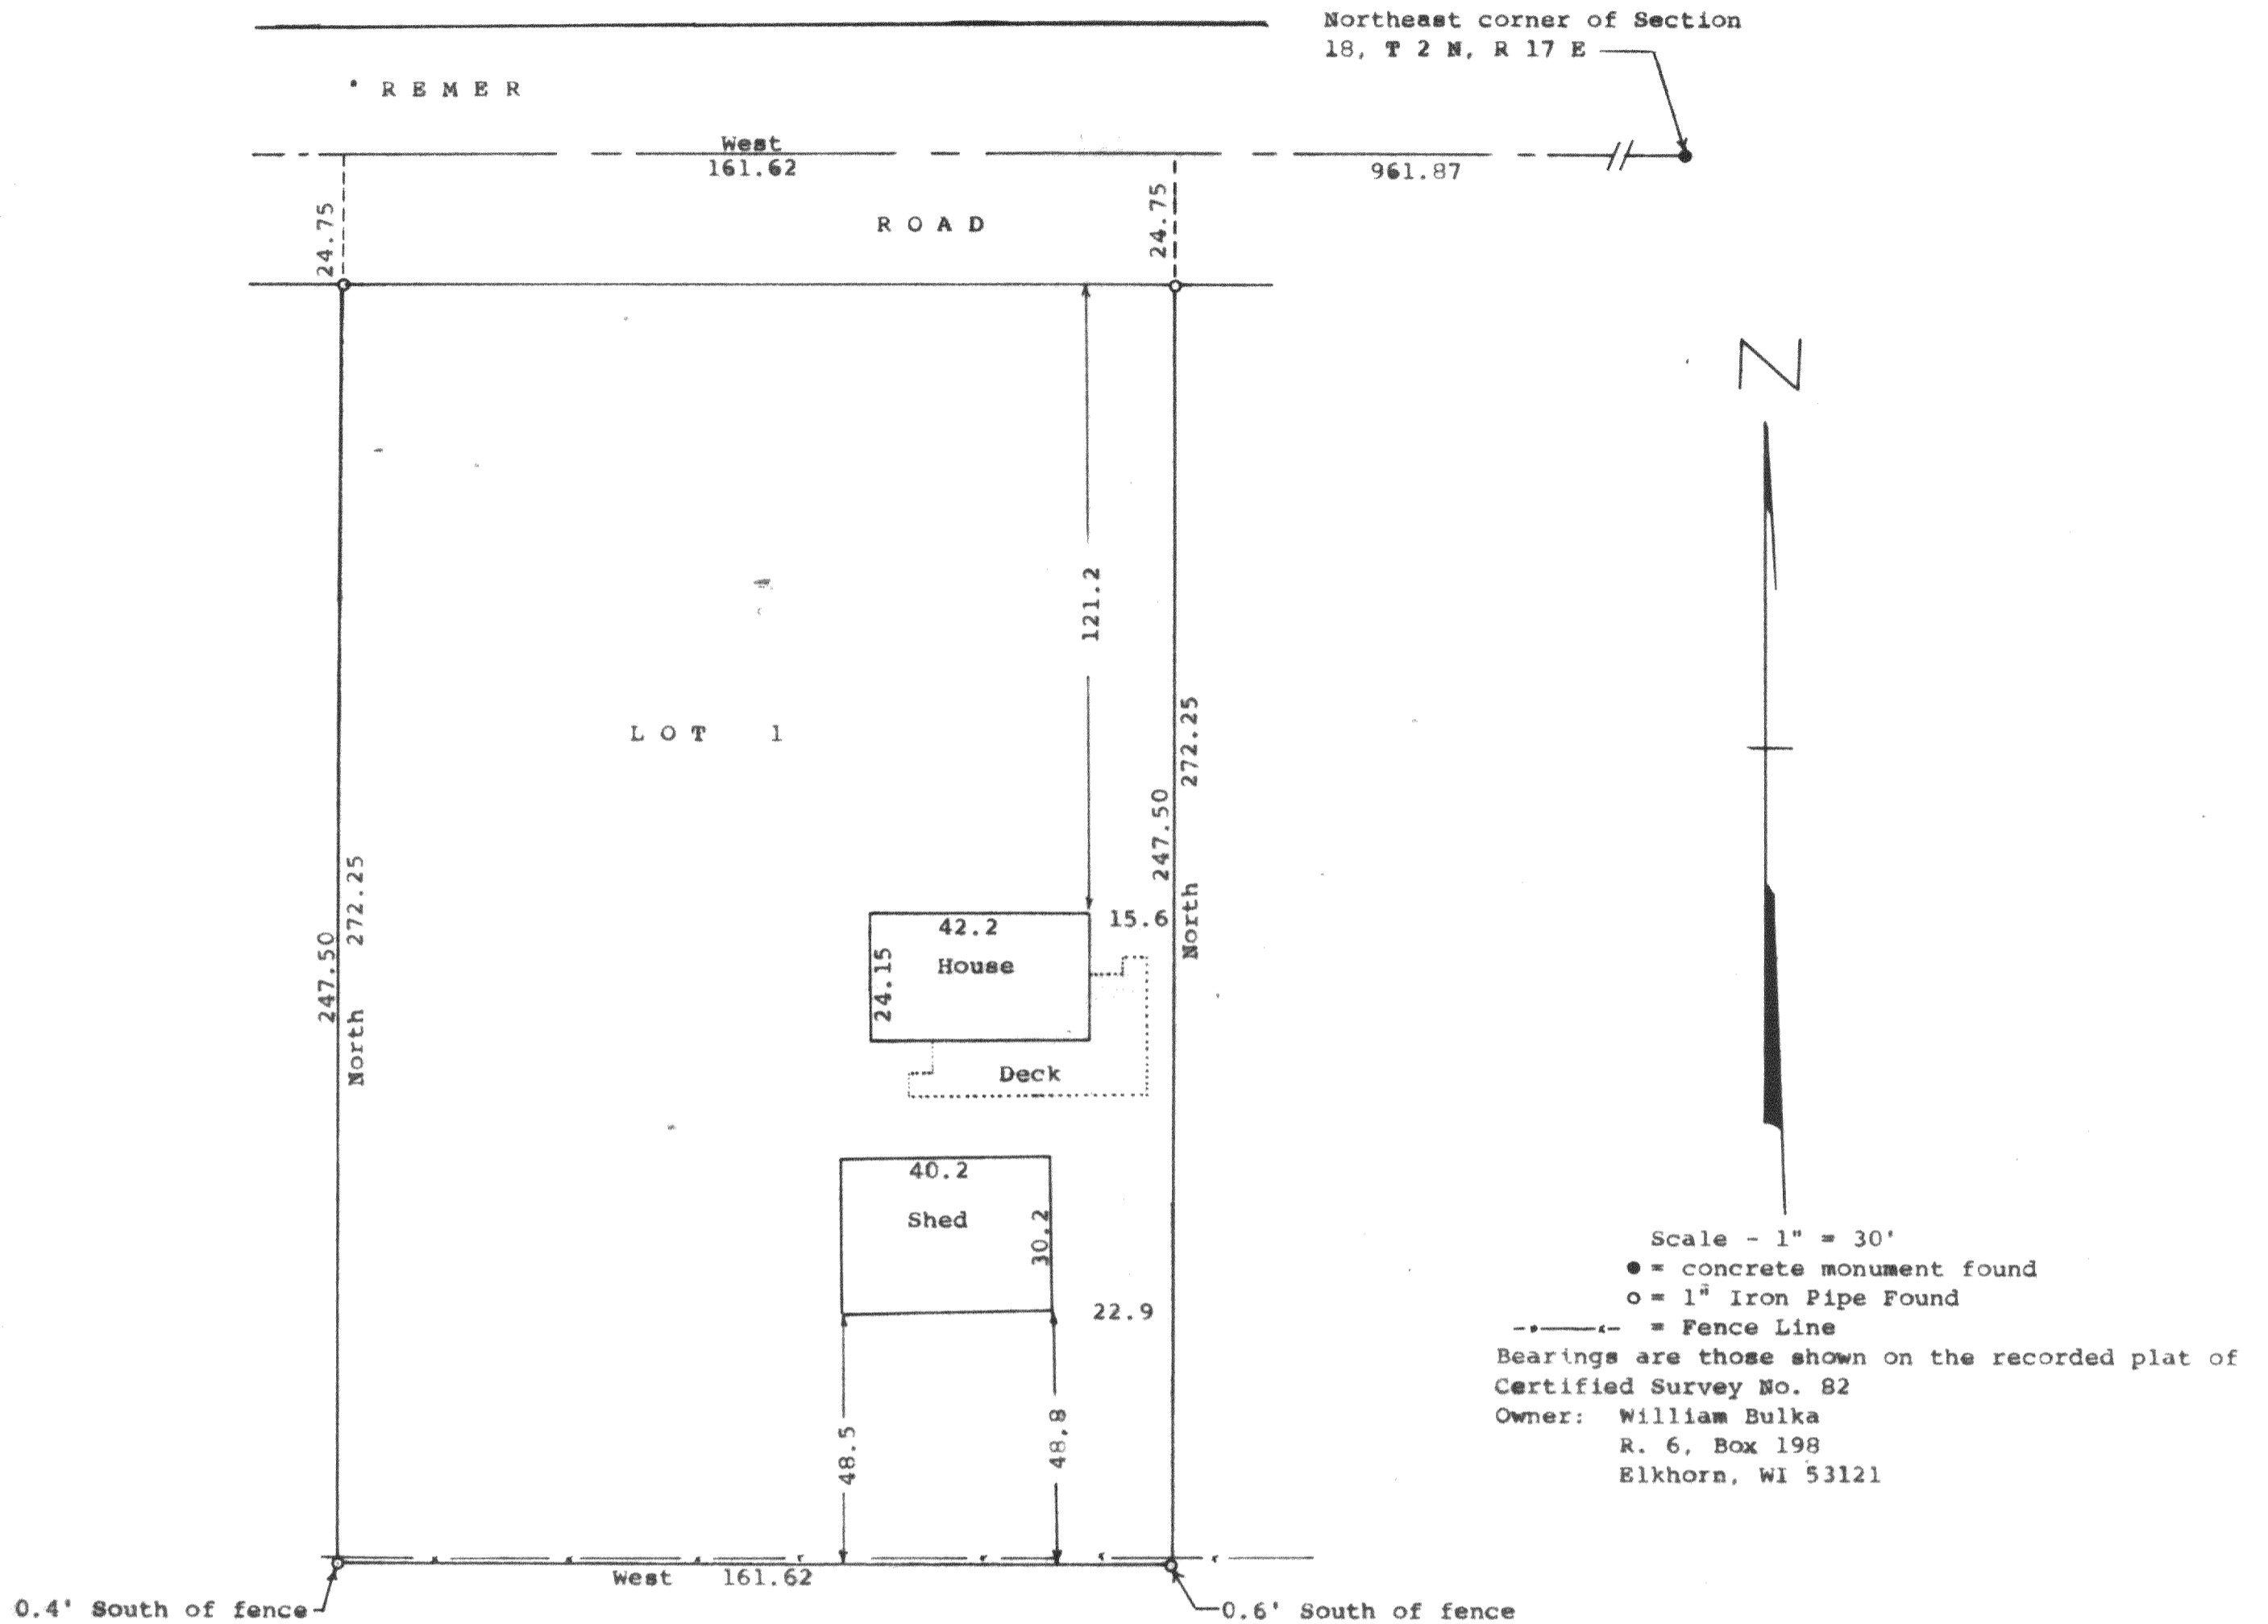


STATE OF WISCONSIN)
 COUNTY OF WALWORTH) SS

I, George T. Dunham, Surveyor, certify that I have surveyed the property described as follows:

Lot 1 in Certified Survey No. 82, as recorded in Volume 1 of Certified Surveys, Page 81, Document No. 639433, in the office of the Register of Deeds, Walworth County, Wisconsin, being a parcel of land located in the Northeast 1/4 of Section 18, T 2 N, R 17 E, Walworth County, Wisconsin

and that the plat shown hereon is a correct representation thereof and shows the size and location of the property, its exterior boundaries, the location of all visible structures and dimensions of all principal buildings thereon, boundary fences, apparent easements, roadways and visible encroachments, if any, and that I have surveyed the property hereon described according to the official records, to the best of my knowledge and belief.

October 7, 1988

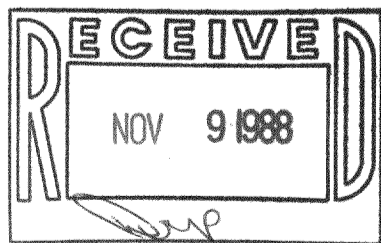

George T. Dunham
 George T. Dunham, Surveyor

