

ABELL SURVEYING & MAPPING

DELAVAN, WISCONSIN 53115 414-729-6737



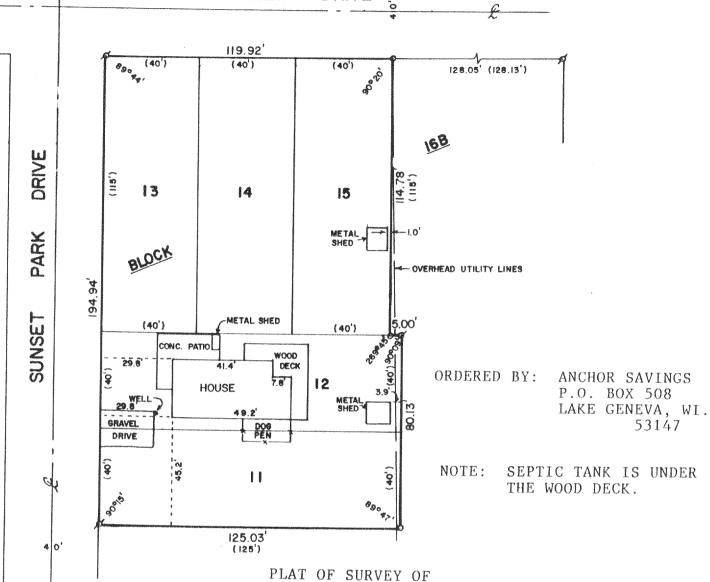

LOTS 11-15, BLOCK 16B, SUNSET HILLS, LOCATED IN T2N,R17E, WALWORTH COUNTY, WISCONSIN.

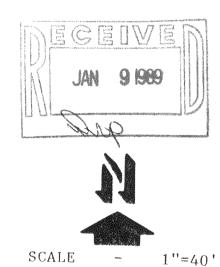

LEGEND σ - IRON PIPE FOUND o - IRON PIPE SET ()- RECORDED AS

I HEREBY CERTIFY THAT I HAVE SURVEYED THE ABOVE DESCRIBED PROPERTY AND THAT THE ABOVE MAP IS A TRUE REPRESENTATION THEREOF AND SHOWS THE SIZE AND LOCATION OF THE PROPERTY, ITS EXTERIOR BOUNDARIES, THE LOCATION OF ALL VISIBLE STRUCTURES AND DIMENSIONS OF ALL PRINCIPAL BUILDINGS THEREON, BOUNDARY FENCES, APPARENT EASEMENTS, ROADWAYS AND VISIBLE ENCROACHMENTS, IF ANY, TO THE BEST OF MY KNOWLEDGE AND BELIEF.

THIS SURVEY IS MADE FOR THE USE OF THE PRESENT OWNERS OF THE PROPERTY, AND ALSO THOSE WHO PURCHASE, MORTGAGE, OR GUARANTEE THE TITLE THERETO WITHIN ONE (1) YEAR FROM DATE HEREOF.

DAVID F. ABELL WISCONSIN REGISTERED LAND SURVEYOR, S-1596

JOB NUMBER - 88214 DATE THIS IS NOT A CERTIFIED COPY UNLESS SEALED.

53147