


KOLB LAND CONSULTING, INC.  
LAND SURVEYING • SUBDIVIDING • LAND PLANNING

929 WILLIAMS STREET LAKE GENEVA, WISCONSIN 53147 414-248-3697


KELLY ROAD 50' WIDE

SUNSET HILLS BLVD. 50' WIDE

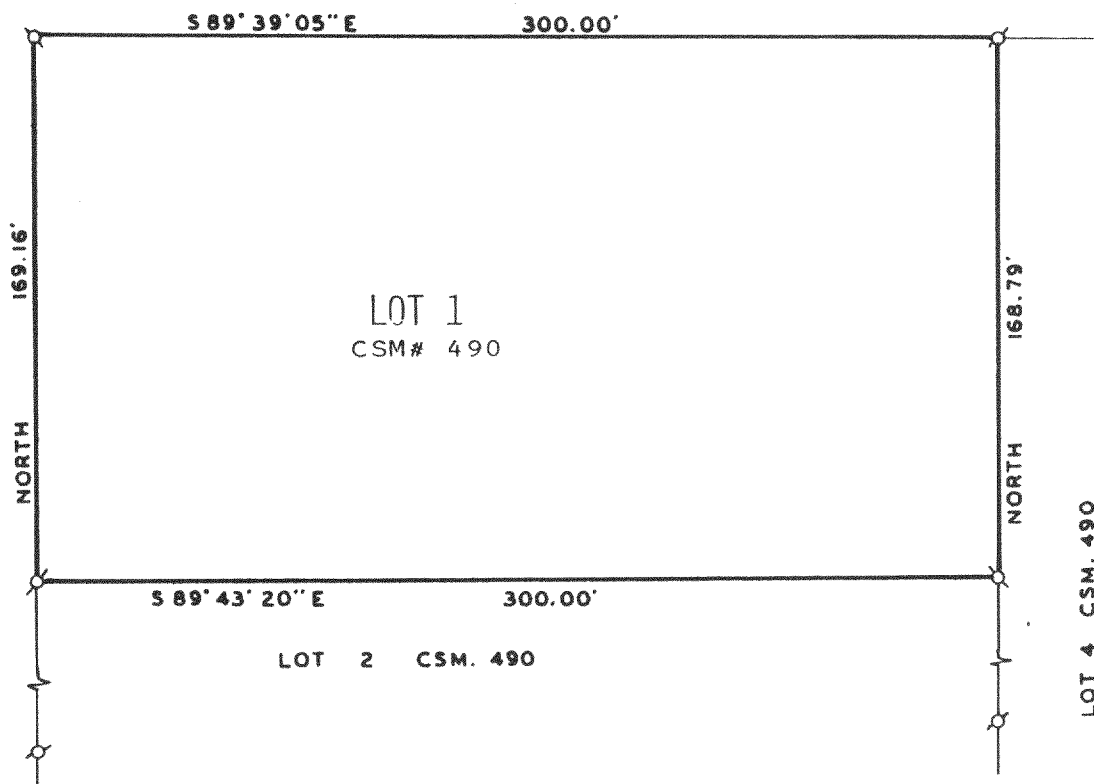

PLAT OF SURVEY OF


LOT 1 OF CERTIFIED SURVEY MAP NO. 490,  
LOCATED IN THE SOUTHEAST 1/4 AND THE  
SOUTHWEST 1/4 OF SECTION 33, T2N, R17E,  
TOWN OF GENEVA, WALWORTH COUNTY, WISCONSIN.

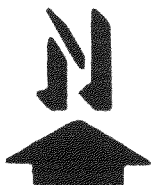

SCALE: 1" = 60'

LEGEND

ø - IRON PIPE FOUND

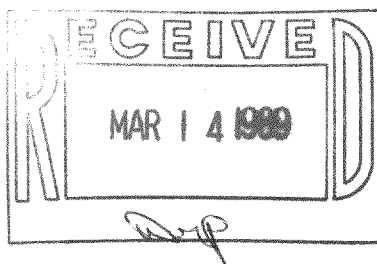

NOTE: BEARINGS ARE ASSUMED AS SHOWN ON  
CSM# 490.

ORDERED BY: MARCY NEWMAN  
180 N. LASALLE 38TH FLOOR  
CHICAGO, IL. 60601

I, HAROLD H. KOLB, DO HEREBY CERTIFY  
THAT I HAVE SURVEYED THE PROPERTY  
HEREON DESCRIBED ACCORDING TO THE  
OFFICIAL RECORDS AND THAT THE PLAT  
HEREON IS A CORRECT REPRESENTATION  
OF THE LOT LINES TO THE BEST OF MY  
KNOWLEDGE AND BELIEF.  
SURVEY NOT VALID UNLESS SURVEYOR'S  
SIGNATURE IS IN RED.

HAROLD H. KOLB

WISCONSIN REGISTERED LAND SURVEYOR, S-187

DATE FEBRUARY 7, 1989

REVISED

REVISED

217-813