
## WALWORTH COUNTY SURVEYING & MAPPING LAKE GENEVA, WISCONSIN



PLAT OF SURVEY OF

LOTS 7313-7317 AND 7345-7349, BLOCK 125 OF LAKE COMO BEACH SUBDIVISION, LOCATED IN T 2 N, R 17 E, WALWORTH COUNTY, WISCONSIN.

ORDERED BY: REALTY WORLD-TAGGART 756 MAIN STREET LAKE GENEVA, WISCONSIN 53147

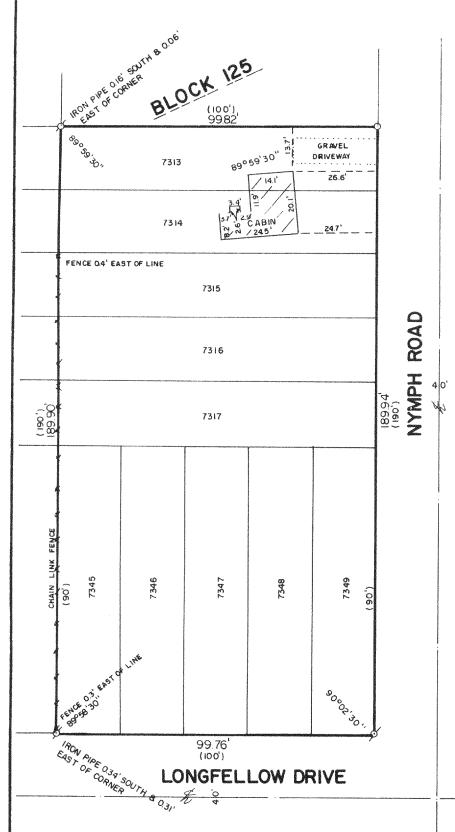

SCALE: 1"=30'

ø-IRON PIPE FOUND
o-IRON PIPE PLACED

()-RECORDED AS

IMEREBY CERTIFY THAT I HAVE SURVEYED THE ABOVE DESCRIBED PROPERTY AND THAT THE ABOVE MAP IS A TRUE REPRESENTATION THEREOF AND BHOWS THE SIZE AND LOCATION OF THE PROPERTY, ITS EXTERIOR BOUNDARIES, THE LOCATION OF ALL VISIBLE STRUCTURES AND DIMENSIONS OF ALL PRINCIPAL BUILDINGS THEREON, BOUNDARY FENCES, APPARENT EASEMENTS AND ROADWAYS AND VISIBLE ENCROACHMENTS, IF ANY.

THIS SURVEY IS MADE FOR THE EXCLUSIVE USE OF THE PRESENT OWNERS OF THE PROPERTY, AND ALSO THOSE WHO PURCHASE, MORTBAGE, OR GUARANTEE THE TITLE THERETO WITHIN ONE (1) YEAR FROM DATE HEREOF.

ROBERT M. BAERENWALD

WISCONSIN REGISTERED LAND SURVEYOR, S-1508

DATE July 6, 1989

JOB NO. 2053

NOTE: THIS IS NOT A CERTIFIED COPY UNLESS SEALED.

Survey#217-885

TAX KEY#JLCBOISSI