


WALWORTH COUNTY
SURVEYING & MAPPING
LAKE GENEVA, WISCONSIN
414-248-0505


WILLIAMS STREET

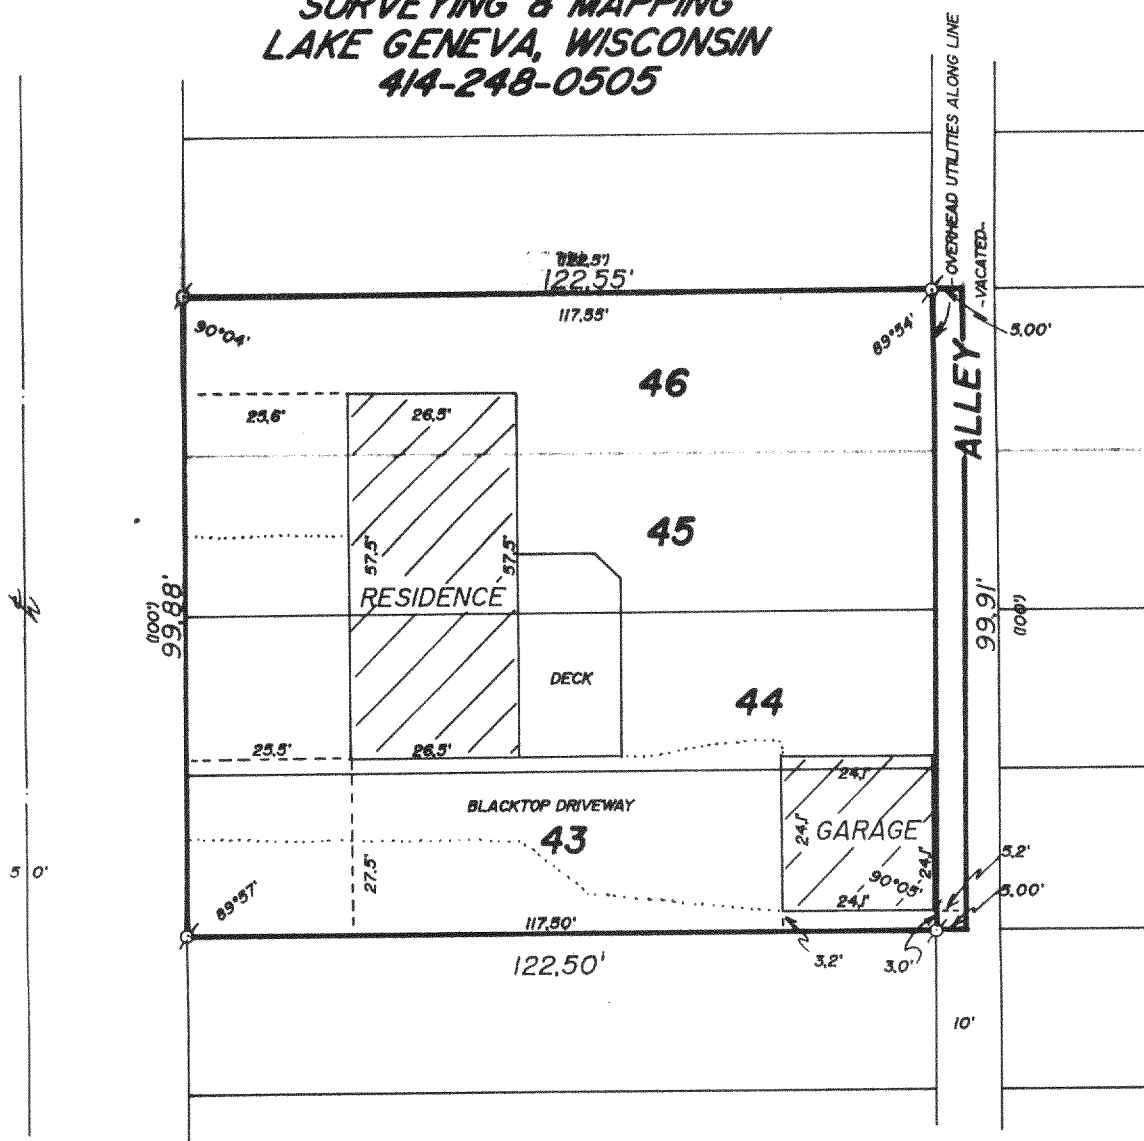

PLAT OF SURVEY OF


LOTS 43-46 OF GUMMOW ADDITION, LOCATED IN
SECTION 25, T 2 N, R 17 E, WALWORTH COUNTY,
WISCONSIN. TOGETHER WITH THE WEST $\frac{1}{2}$ OF THE
VACATED ALLEY ABUTTING THE ABOVE DESCRIBED
PREMISES.

ORDERED BY: REDELL REALTY
LAKE GENEVA, WISCONSIN
53147

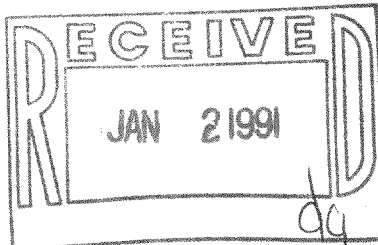

I HEREBY CERTIFY THAT I HAVE SURVEYED THE ABOVE DESCRIBED PROPERTY AND THAT
THE ABOVE MAP IS A TRUE REPRESENTATION THEREOF AND SHOWS THE SIZE AND
LOCATION OF THE PROPERTY, ITS EXTERIOR BOUNDARIES, THE LOCATION OF ALL VISIBLE
STRUCTURES AND DIMENSIONS OF ALL PRINCIPAL BUILDINGS THEREON, BOUNDARY FENCES,
APPARENT EASEMENTS AND ROADWAYS AND VISIBLE ENCROACHMENTS, IF ANY, TO THE
BEST OF MY KNOWLEDGE AND BELIEF.

THIS SURVEY IS MADE FOR THE USE OF THE PRESENT OWNERS OF THE PROPERTY AND
ALSO THERE UNDERTAKING PURCHASE, MORTGAGE OR GUARANTEE THE TITLE THERE TO WITHIN
ONE (1) YEAR FROM DATE HEREOF.

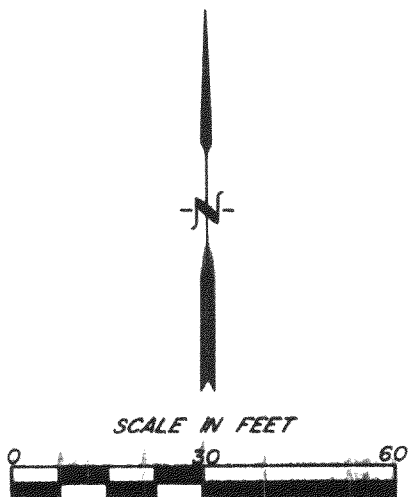

⊕ - IRON PIPE FOUND
() - RECORDED A/C

Robert M. Baumann
ROBERT M. BAUMANN
WISCONSIN REGISTERED LAND SURVEYOR S-1500

OCT. 16, 1989
DATE JOB NO. 2206

NOTE: THIS IS NOT A CERTIFIED COPY UNLESS SEALED

REVISED: OCT. 17, 1989

Survey # 217-889

TAX KEY # JGum 00011A