


KOLB LAND CONSULTING, INC.
LAND SURVEYING • SUBDIVIDING • LAND PLANNING

LAKE GENEVA, WISCONSIN 53147

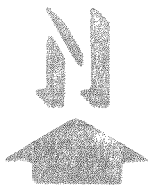


SCALE: 1" = 100'

LEGEND

Ø IRON PIPE FOUND


NOTE: BEARINGS ARE ASSUMED AS SHOWN
ON CERTIFIED SURVEY MAP NO. 1402.

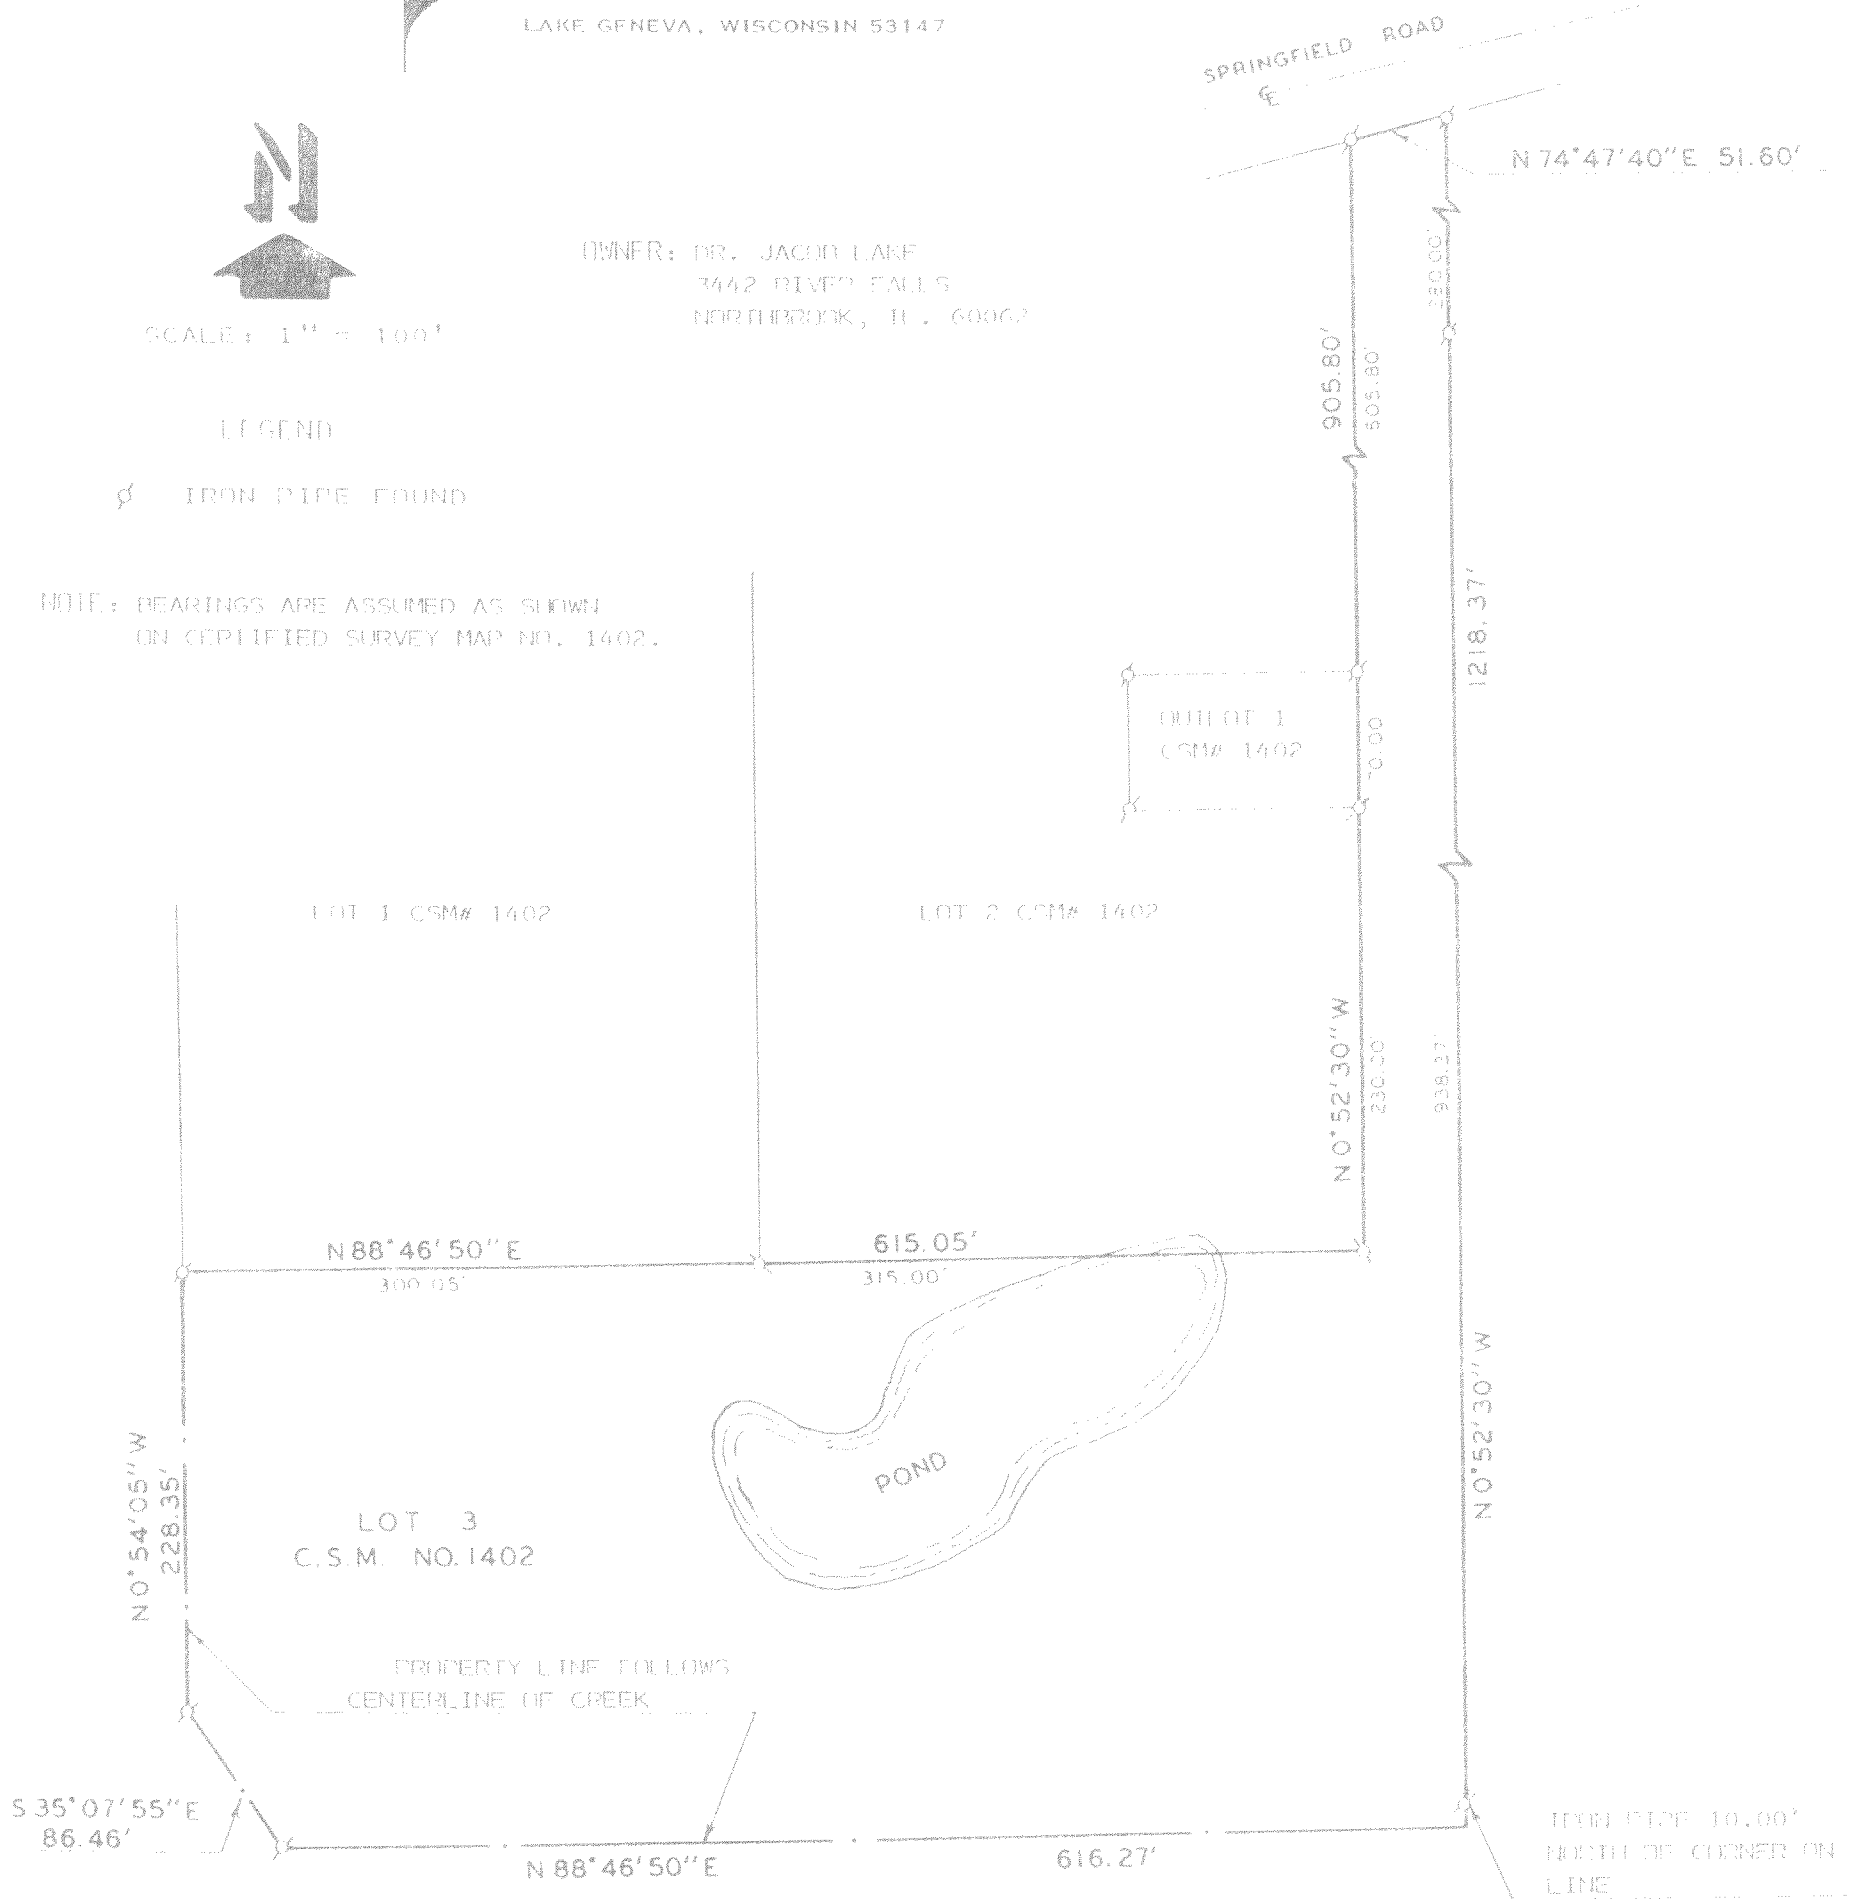

PLAT OF SURVEY OF

LOT 3 OF CERTIFIED SURVEY MAP NO. 1402, LOCATED
IN THE NORTHEAST 1/4 AND THE NORTHWEST 1/4 OF
SECTION 13, T2N, R17E, TOWN OF GENEVA, WALWORTH
COUNTY, WISCONSIN.

I, HAROLD H. KOLB, DO HEREBY CERTIFY
THAT I HAVE SURVEYED THE PROPERTY
HEREON DESCRIBED ACCORDING TO THE
OFFICIAL RECORDS AND THAT THE PLAT
HEREON IS A CORRECT REPRESENTATION
OF THE LOT LINES TO THE BEST OF MY
KNOWLEDGE AND BELIEF.
SURVEY NOT VALID UNLESS SURVEYOR'S
SIGNATURE IS IN RED.

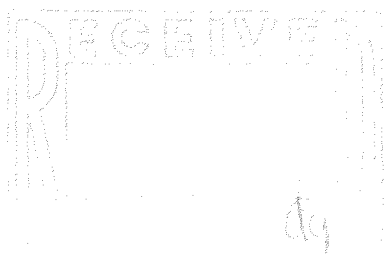

HAROLD H. KOLB

WISCONSIN REGISTERED LAND SURVEYOR, S-117
DATE DECEMBER 20, 1999