


KOLB LAND CONSULTING, INC.  
 LAND SURVEYING • SUBDIVIDING • LAND PLANNING

LAKE GENEVA, WISCONSIN 53147

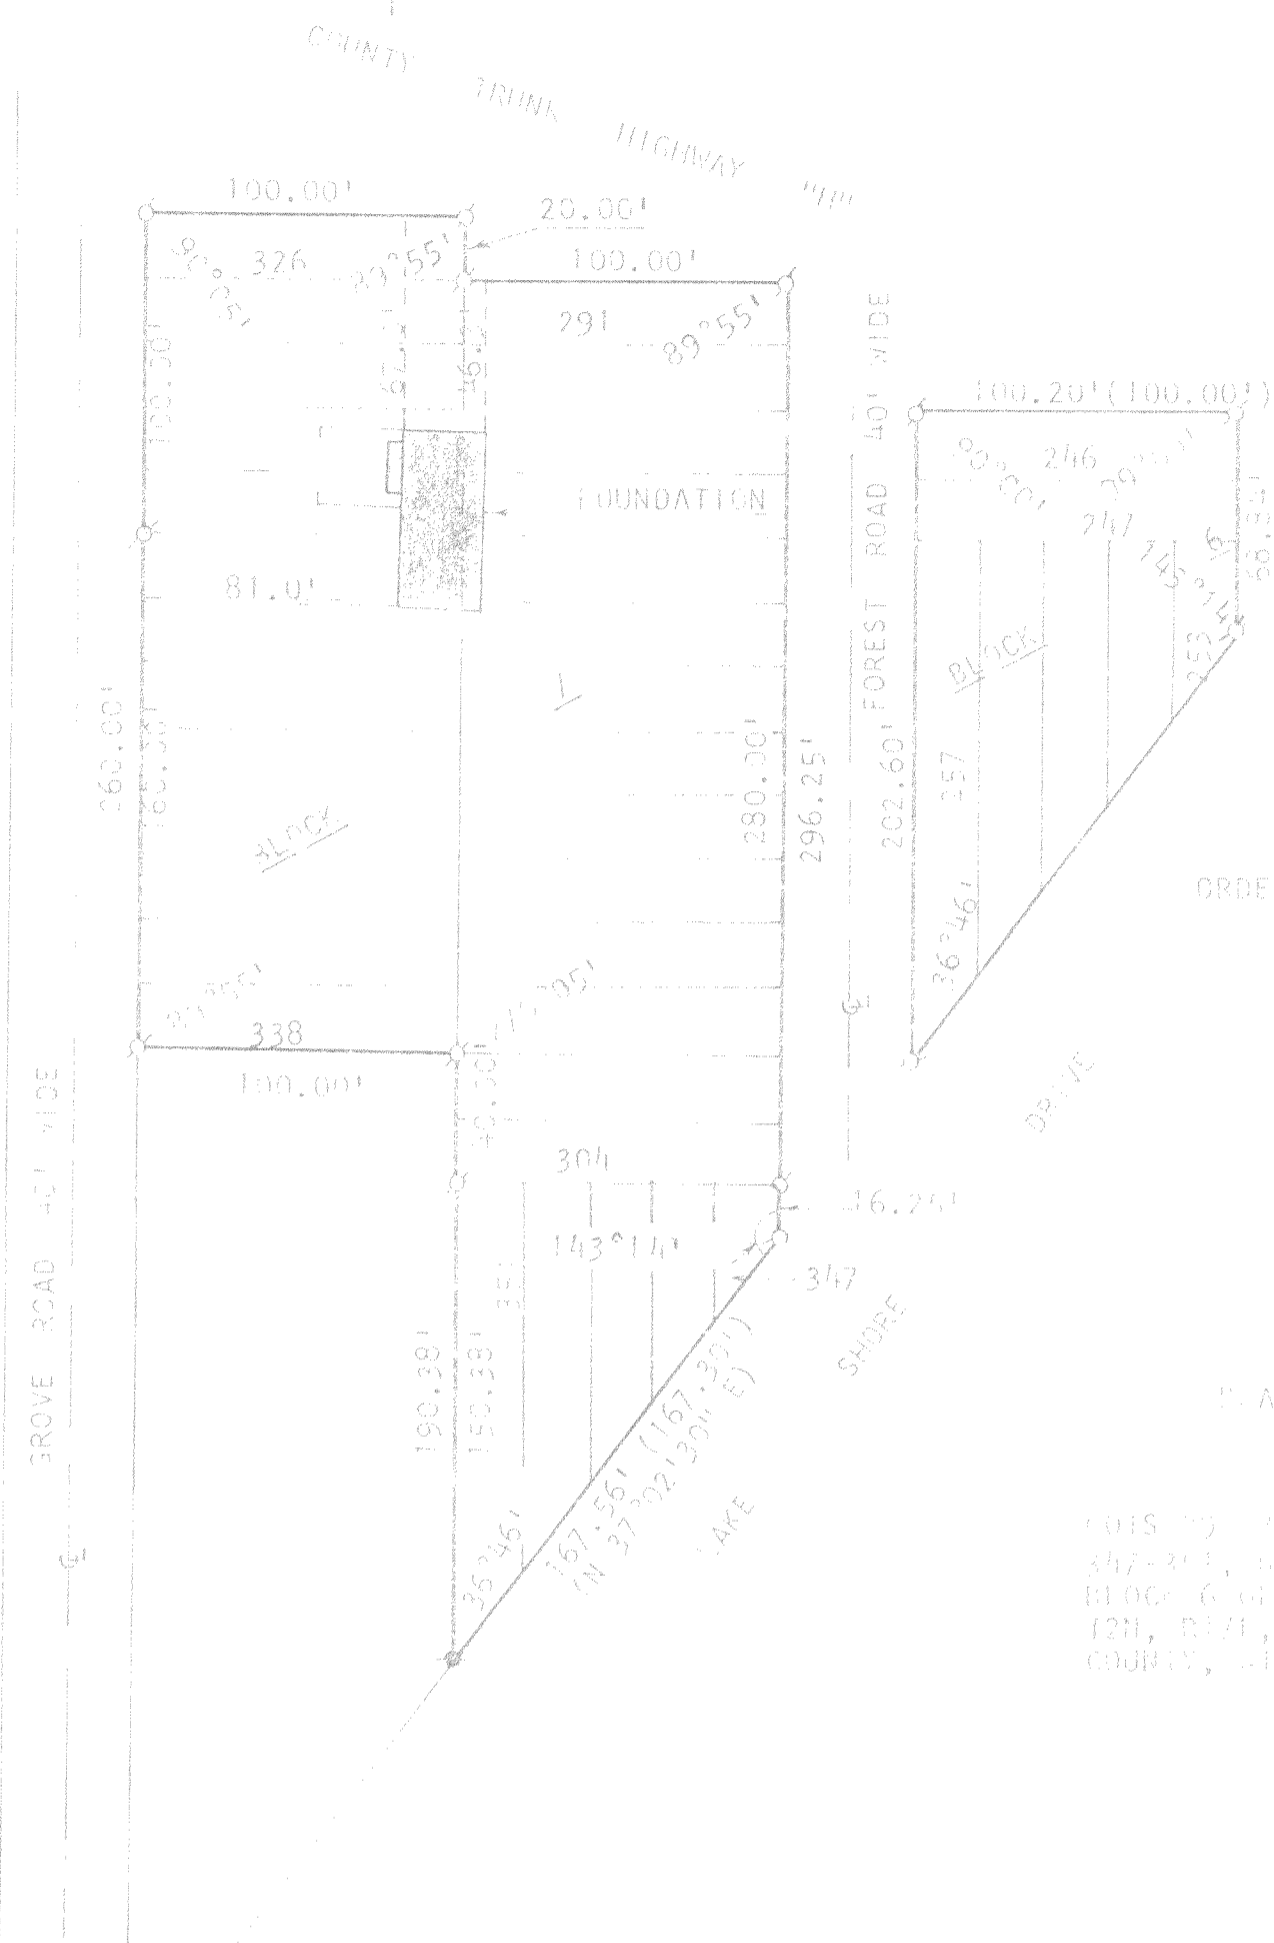


LEGEND  
 ♂ - IRON PIPE FOUND  
 ♀ - IRON ROD FOUND  
 ( ) - AS RECORDED

ORDERED BY:  
 5-STAR HOMES  
 90 E. GENEVA SQUARE  
 LAKE GENEVA, WI. 53147

PLAN OF FOUNDATION  
 (SEE PAGE 2)

LOTS 296-300 AND LOTS 306-308, LOTS 347-351, BLOCK 6 AND LOTS 346-347, BLOCK 6 OF LAKE COME BEACH SUBDIVISION, T2N, R2E, TOWN OF GENEVA, WALWORTH COUNTY, WISCONSIN.

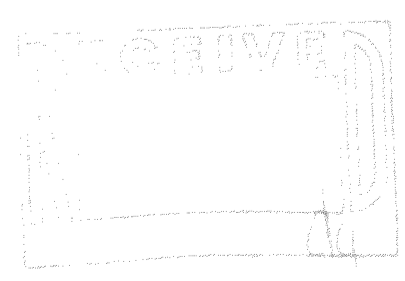

I, HAROLD H. KOLB, DO HEREBY CERTIFY THAT I HAVE SURVEYED THE PROPERTY HEREON DESCRIBED ACCORDING TO THE OFFICIAL RECORDS AND THAT THE PLAT HEREON IS A CORRECT REPRESENTATION OF THE LOT LINES AND THE PRINCIPAL LINES OF THE FOUNDATION, TO THE BEST OF MY KNOWLEDGE AND BELIEF. SURVEY NOT VALID UNLESS SURVEYOR'S SIGNATURE IS IN RED.

HAROLD H. KOLB  
 WISCONSIN REGISTERED LAND SURVEYOR, S. 187  
 DATE APRIL 26, 1950