


GEORGE T. DUNHAM
 SURVEYING & SUBDIVIDING
 DELAVAN, WISCONSIN

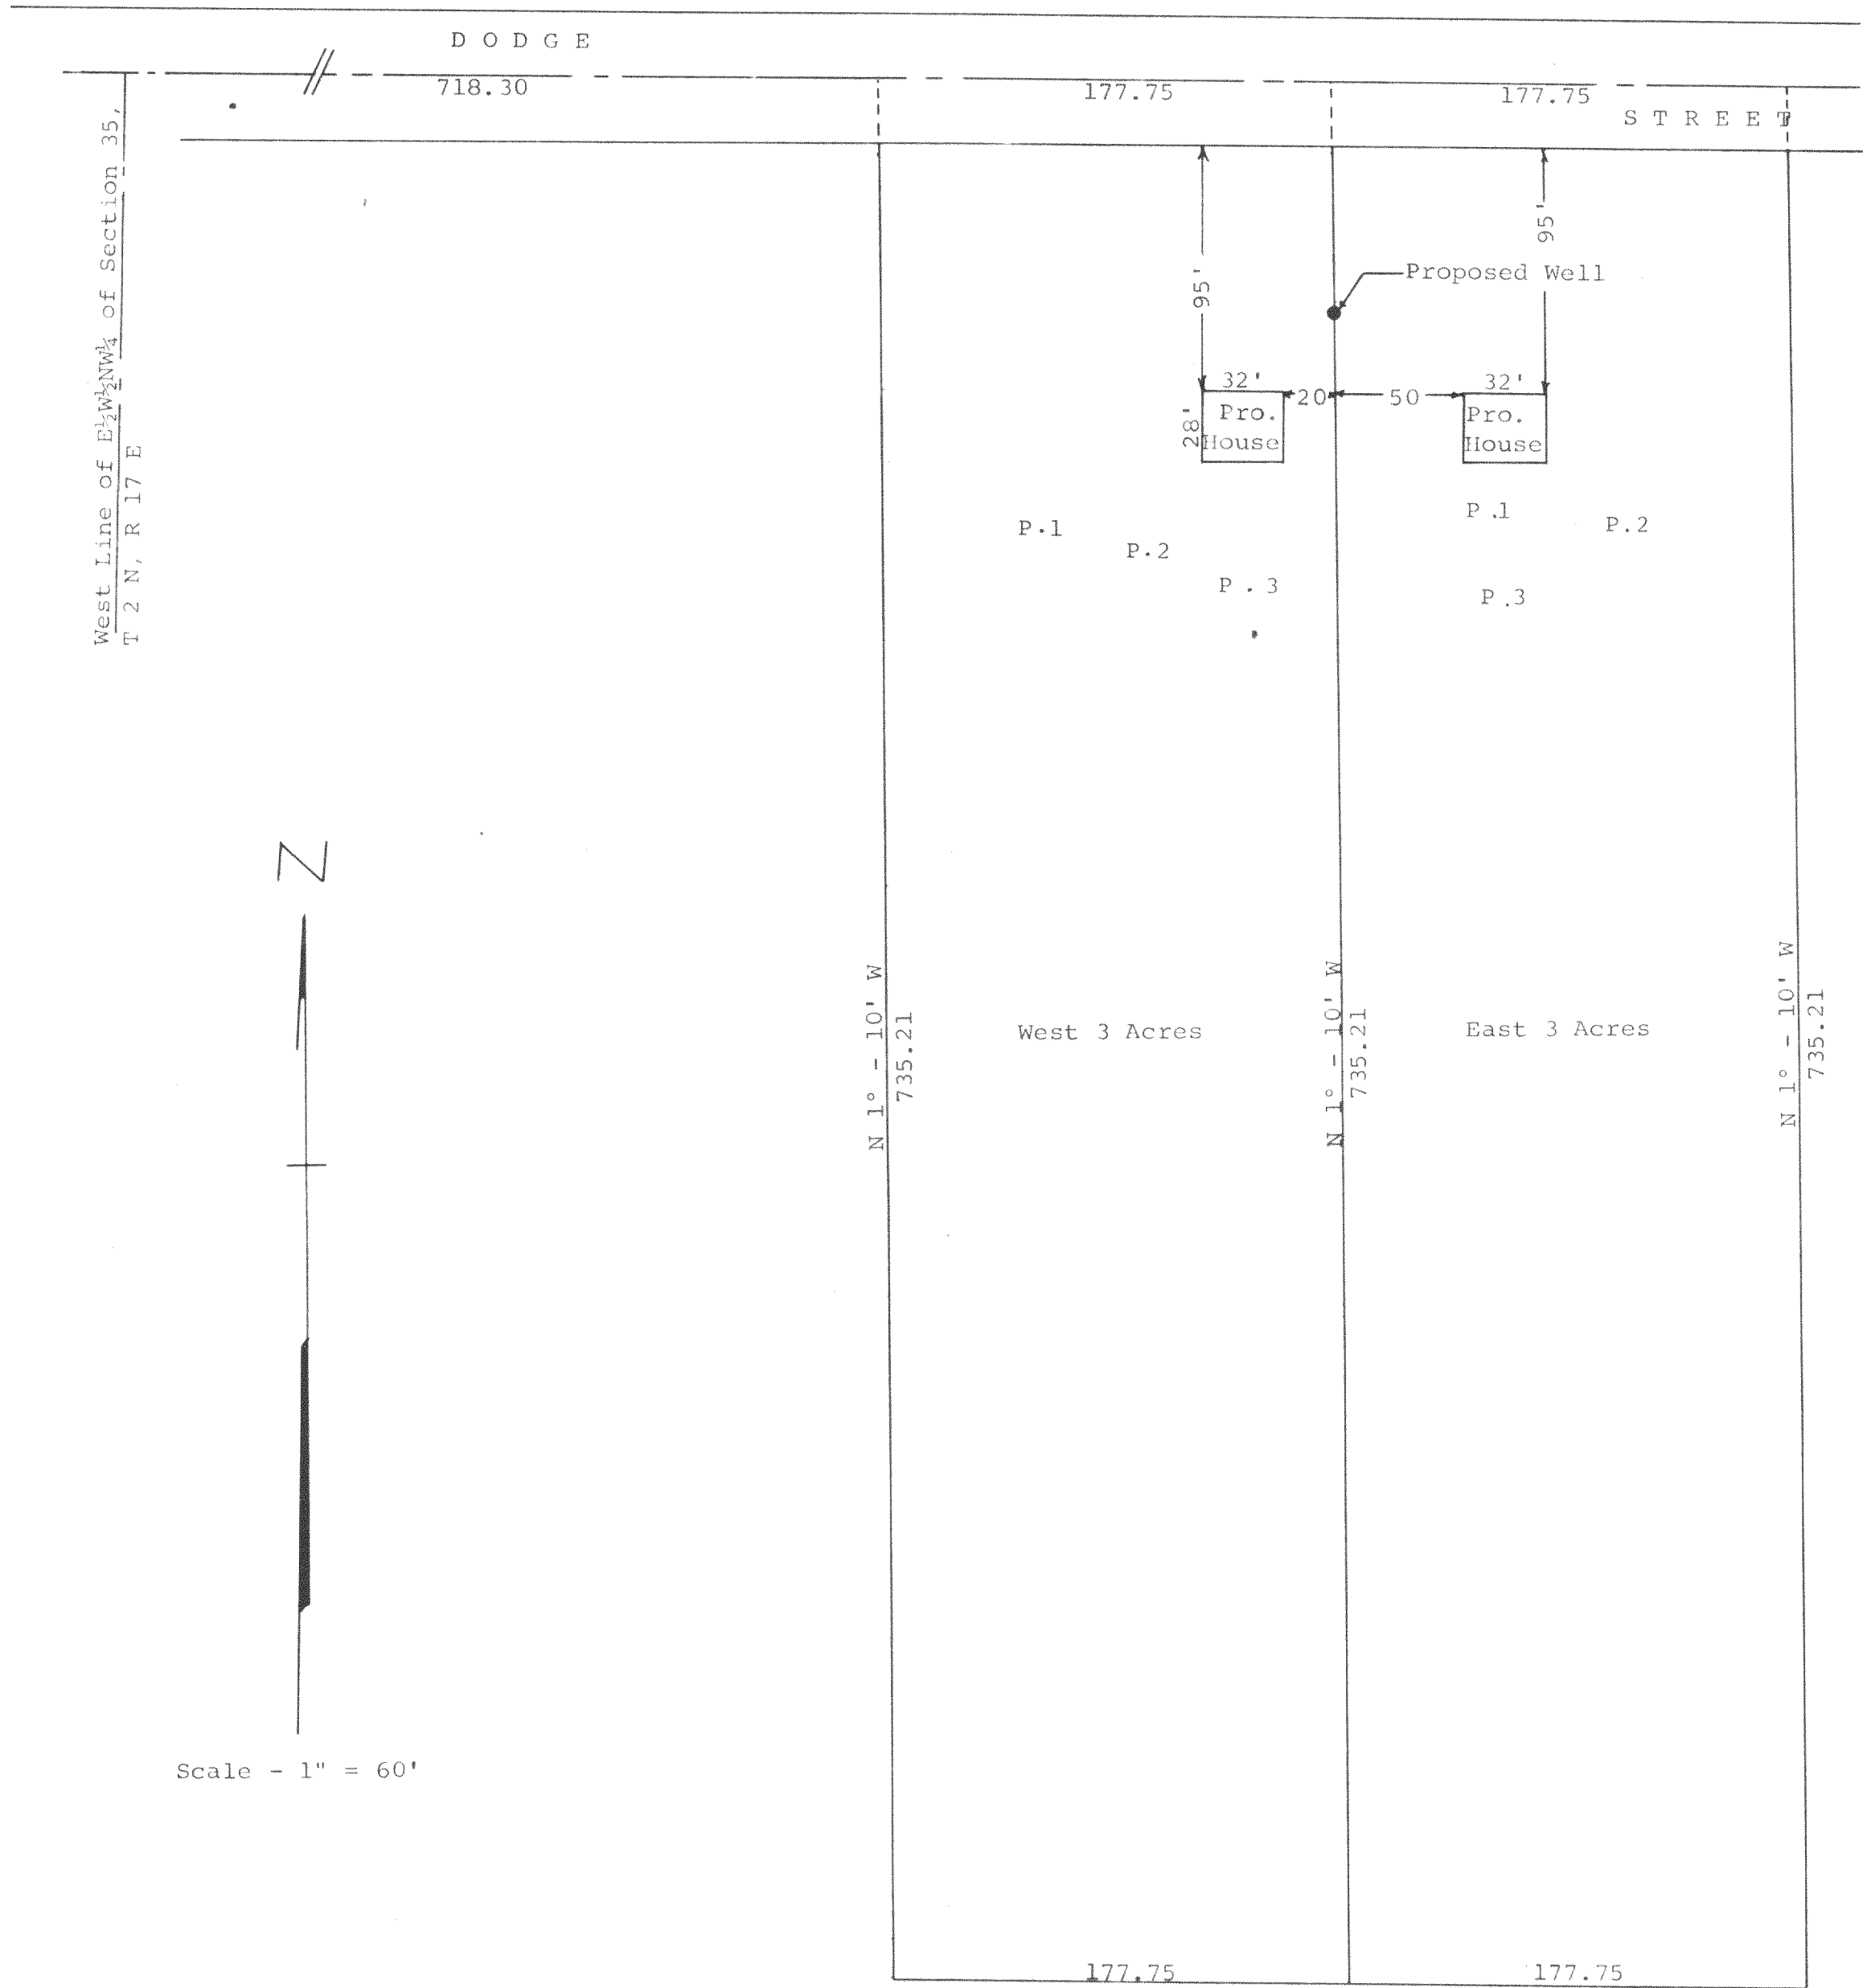

Plat showing the location of the percolation tests made on property owned by Walter Swanson located in the Northwest ¼ of Section 35, T 2 N, R 17 E, Walworth County, Wisconsin. August 3, 1967

George T. Dunham
 George T. Dunham, Surveyor

G-35-5
 4 50