

Wisconsin Registered Land Surveyor S-1594

Rt. 3, Box 273
Elkhorn, Wisconsin 53121
Phone: (414) 723-4260 (office)
(414) 723-7209 (FAX)

PLAT OF SURVEY

LOT 19 OF GENEVA TERRITORY FIRST ADDITION, LOCATED IN THE
SOUTHWEST 1/4 OF SECTION 28, THE SOUTHEAST 1/4 OF SECTION
29, THE NORTHEAST 1/4 OF SECTION 32 AND THE NORTHWEST 1/4 OF
SECTION 33, TOWN 2 NORTH, RANGE 18 EAST, WALWORTH COUNTY,
WISCONSIN.

ORDERED BY: KEEFE REAL ESTATE
PATTI KIRCHHOFF
P.O. BOX 460
LAKE GENEVA, WI. 53147


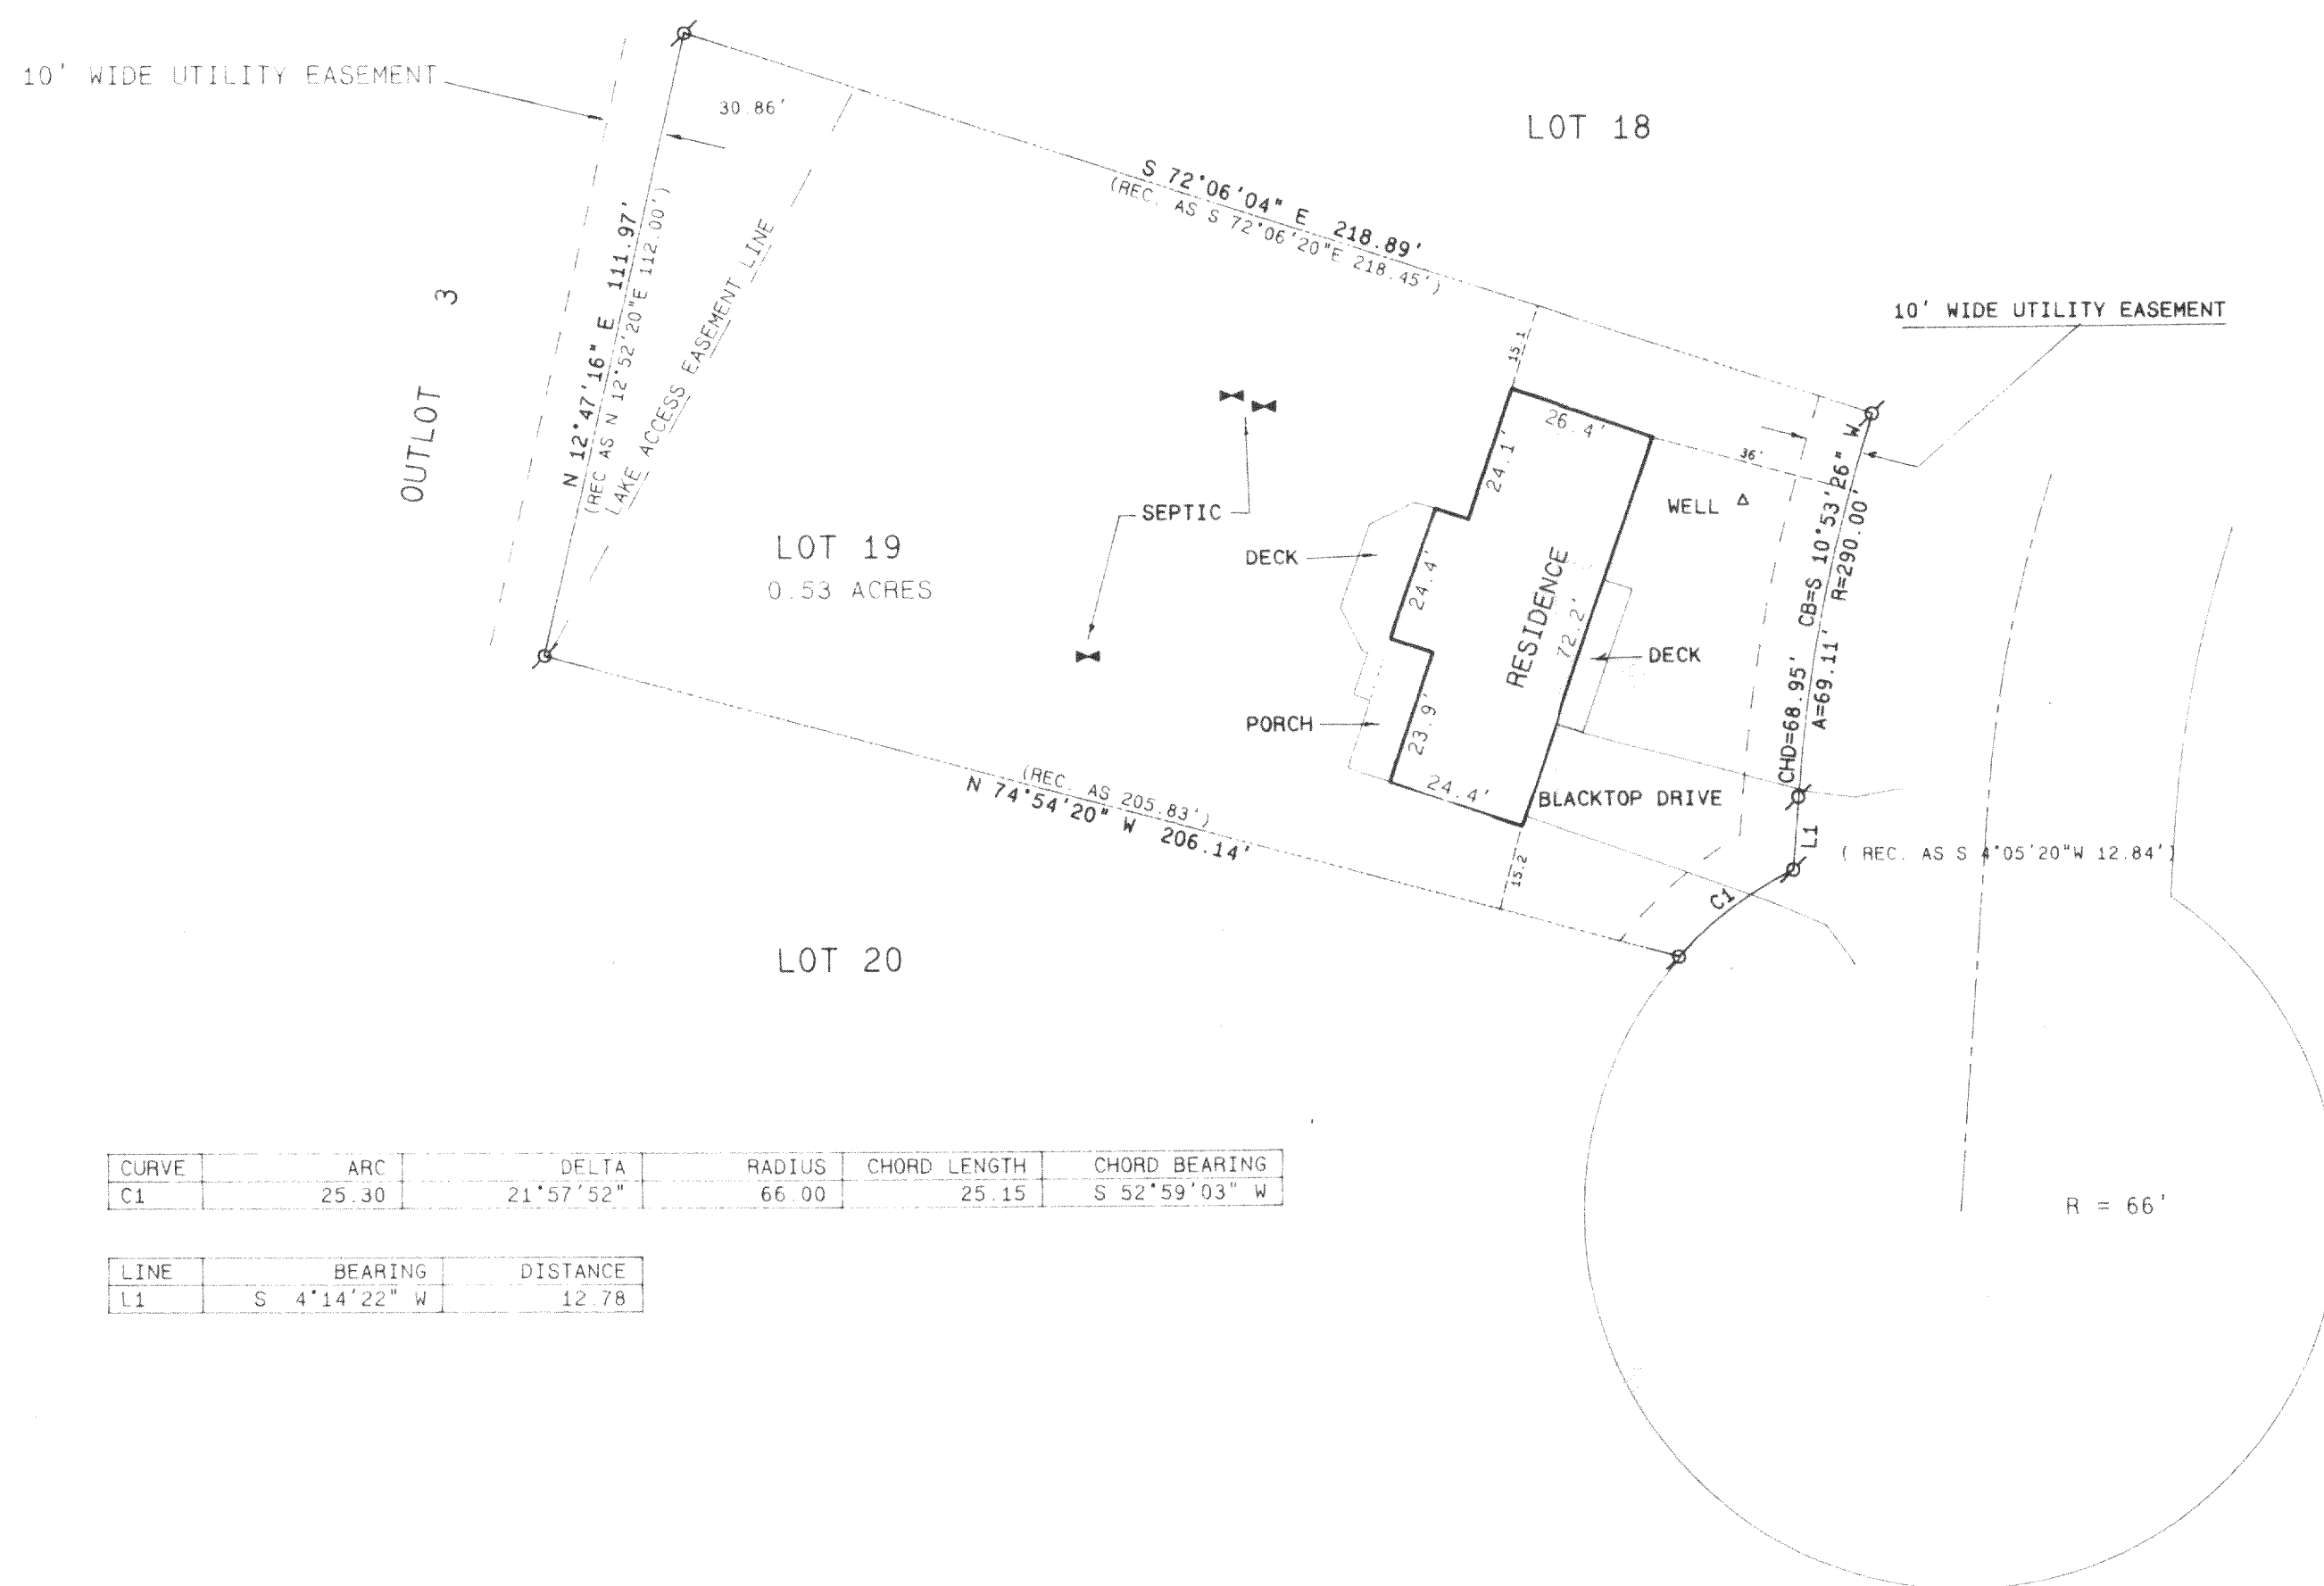


Figure 1 is a plan view map of the study area. It shows the coastline of the Gulf of Mexico, the Mississippi River, and the proposed offshore wind farm layout. The map includes a scale bar (1 inch = 30 feet) and a north arrow.

Legend

- 1" FOUND IRON PIPE
 ● FOUND IRON ROD
 ○ FOUND BRASS CAPPED MONUMENT
 ✕ FOUND CONCRETE MONUMENT
 + CHISEL CUT IN CONCRETE
 ● SET IRON ROD, 24" LONG, WEIGHING
 1.5 LBS./LINEAL FT., 3/4" DIA.
 ● SET IRON ROD, 30" LONG, WEIGHING
 4.5 LBS./LINEAL FT., 1-11/16" DIA.
 (xx) RECORDED AS DIMENSION
 — x — x — EXISTING FENCE

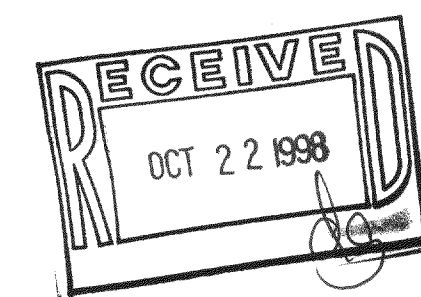


SCALE: 1" = 30 FEET

"I hereby certify that the above described property has been surveyed by me or under my direction and that the above map is a true representation thereof and shows the size and location of the property, its exterior boundaries, the location of all visible structures and dimensions of all principal buildings thereon, boundary fences, apparent easements, roadways and visible encroachments, if any."

Kenneth B. Auliff.

KENNETH B. ABERNATHY, JR.
WISCONSIN REGISTERED LAND SURVEYOR,
S-1594

Date: APRIL 12, 1991 Job No. 91-406

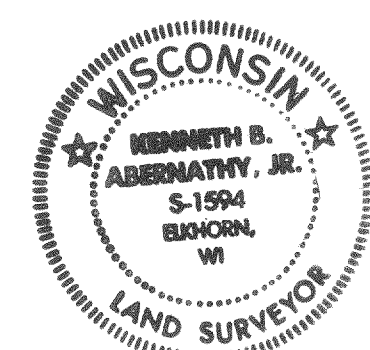

REVISED 9-1-98

218-1025
WDA1-8