


PLAT OF SURVEY

LOT 8 OF THE REPLAT OF STURGIS PARTNERS LTD.
SUBDIVISION, LOCATED IN SECTIONS 22 AND 23, TOWN 2
NORTH, RANGE 18 EAST, TOWN OF LYONS, WALWORTH COUNTY,
WISCONSIN.

OWNER: LORRETTA H. STURGIS
P.O. BOX 149
LYONS, WI. 53148

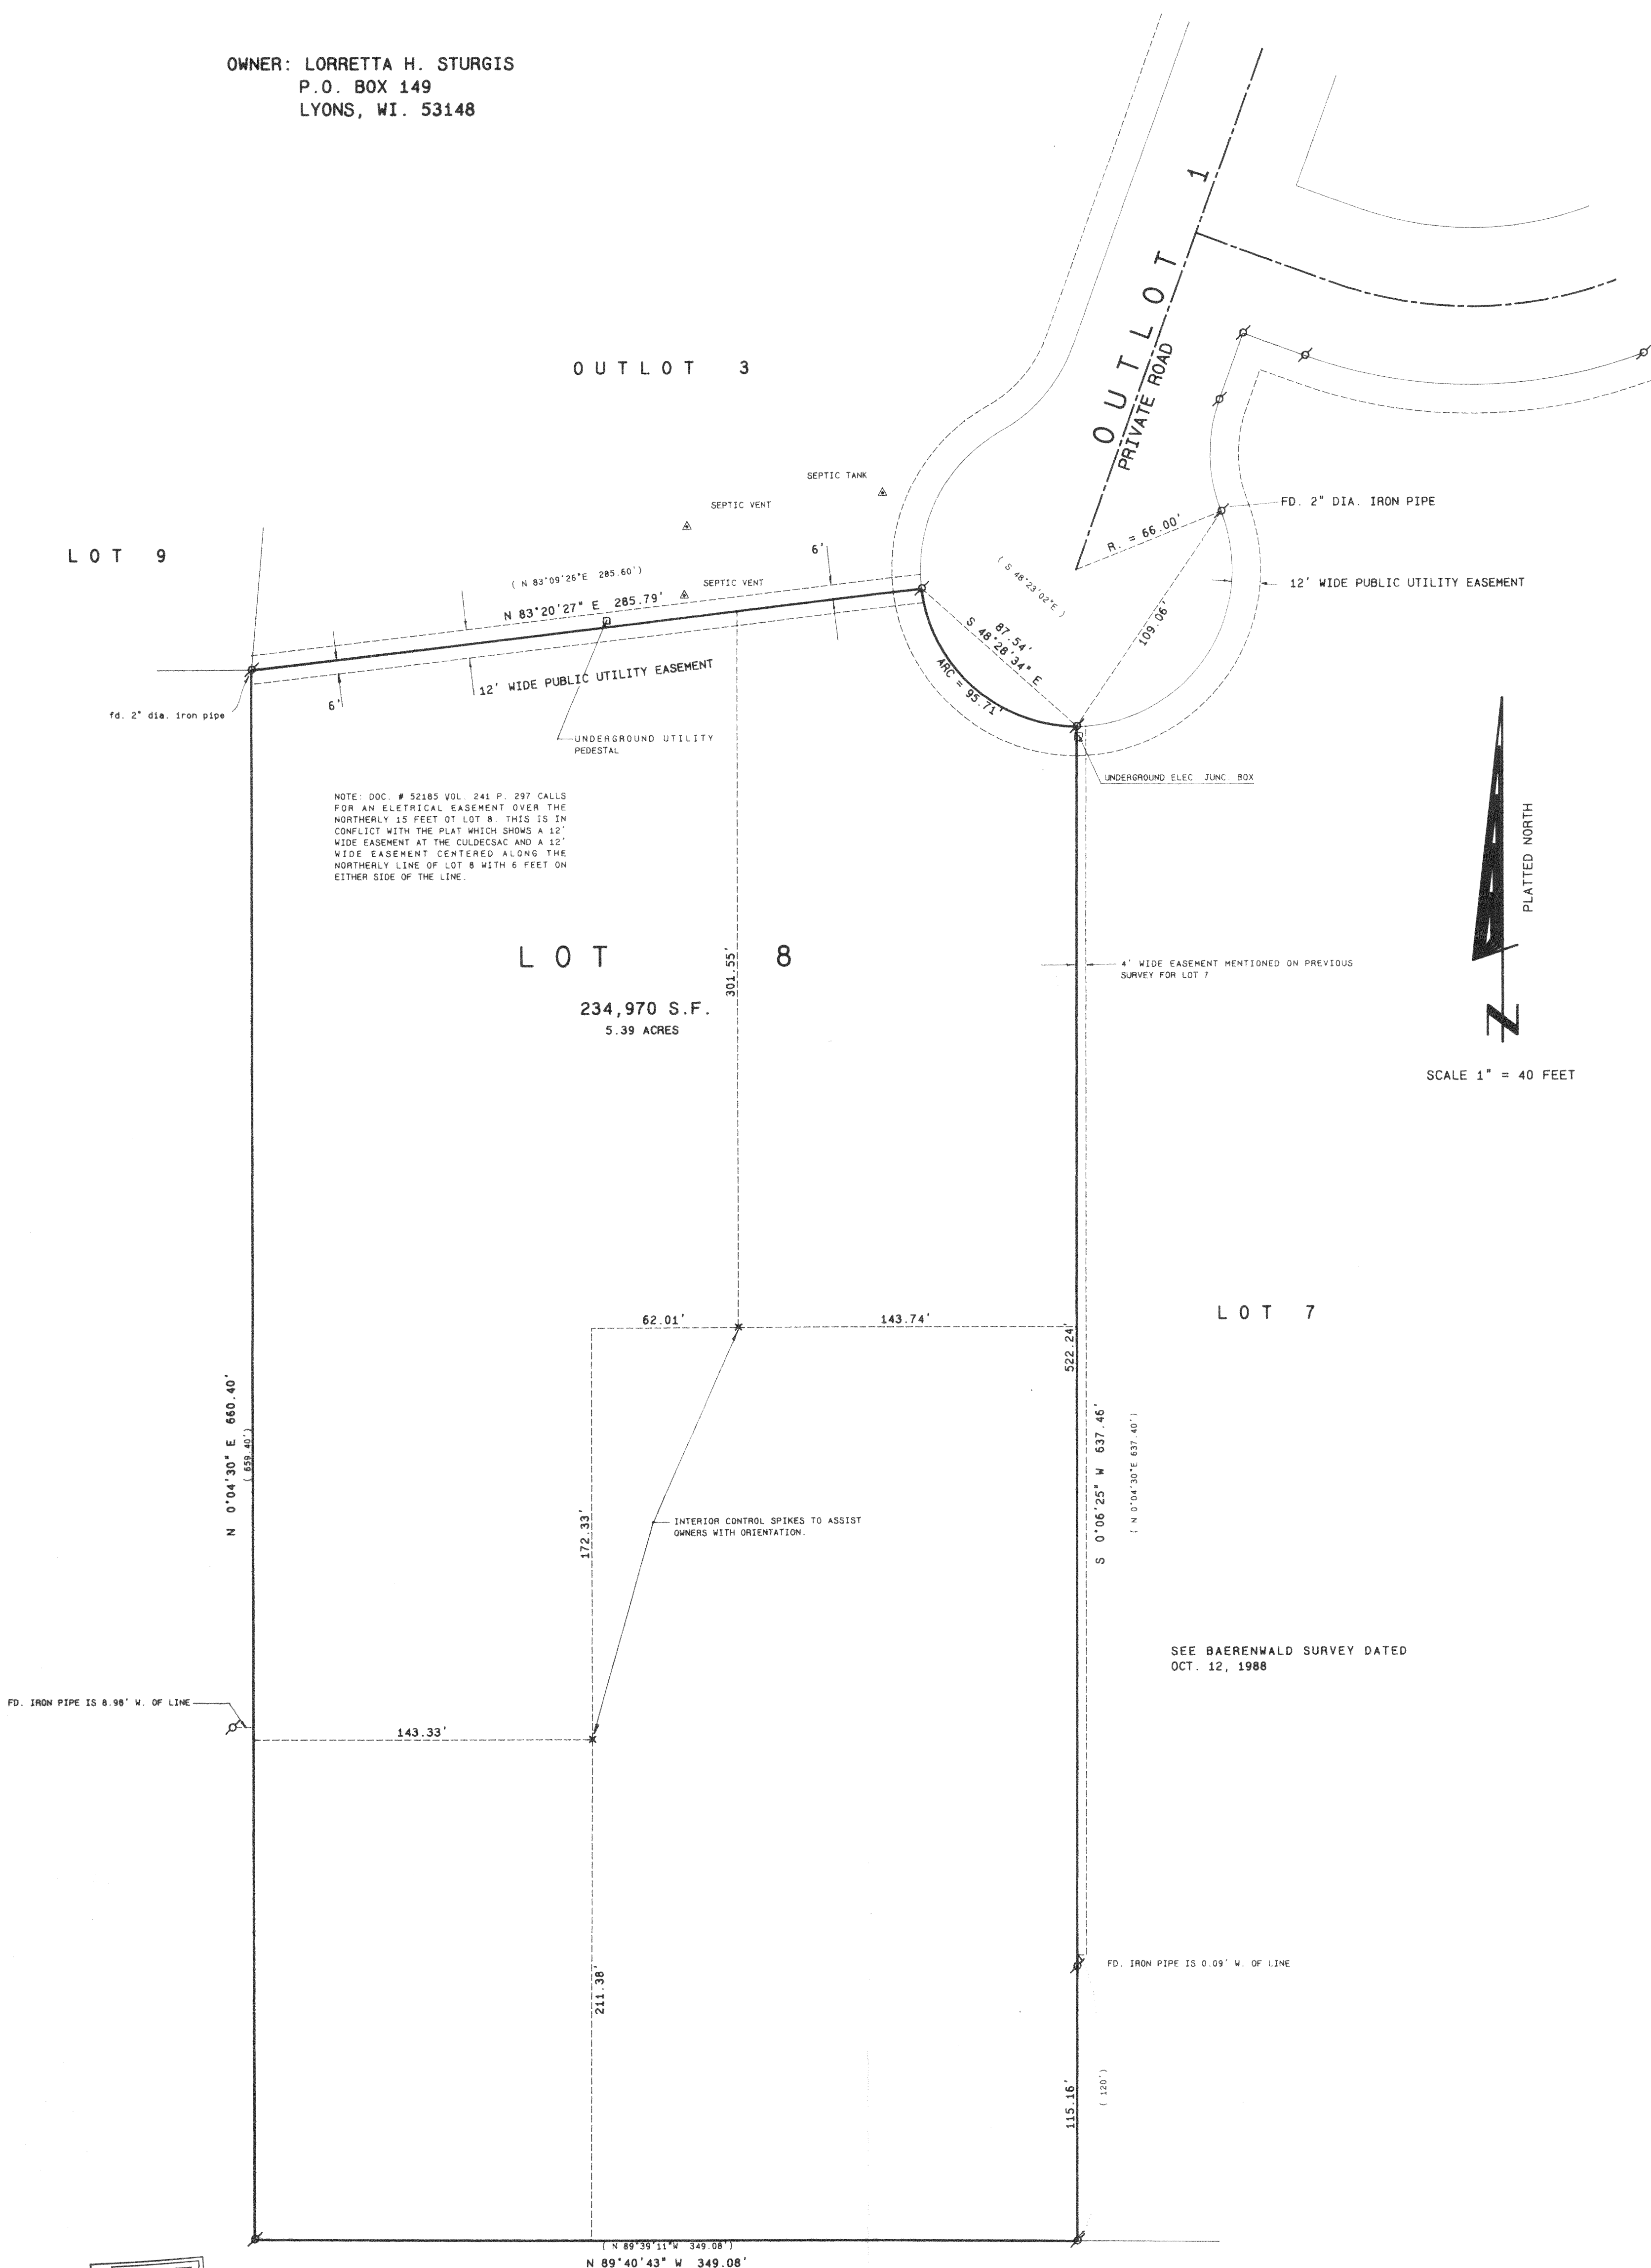

NOTE: DOC. # 52185 VOL. 241 P. 297 CALLS FOR AN ELECTRICAL EASEMENT OVER THE NORTHERLY 15 FEET OF LOT 8. THIS IS IN CONFLICT WITH THE PLAT WHICH SHOWS A 12' WIDE EASEMENT AT THE CULDECSAC AND A 12' WIDE EASEMENT CENTERED ALONG THE NORTHERLY LINE OF LOT 8 WITH 6 FEET ON EITHER SIDE OF THE LINE.

SCALE 1" = 40 FEET

SEE BAERENWALD SURVEY DATED
OCT. 12, 1988

Legend

FOUND IRON PIPE
FOUND IRON ROD
FOUND BRASS CAPED MONUMENT
FOUND CONCRETE MONUMENT
CHISEL CUT IN CONCRETE
SET IRON ROD, 3/4" LONG, WEICHMIND
1.5 LBS./LINEAL FT., 3/8" DIA.
SET IRON ROD, 3/4" LONG, WEICHMIND
4.5 LBS./LINEAL FT., 1-1/16" DIA.
(XX)
RECORDED AS DIMENSION
EXISTING FINISH

218-1028
NVSP-8

SCALE: 1"= 40 FEET

RECEIVED
OCT 22 1998
S

[illegible]