
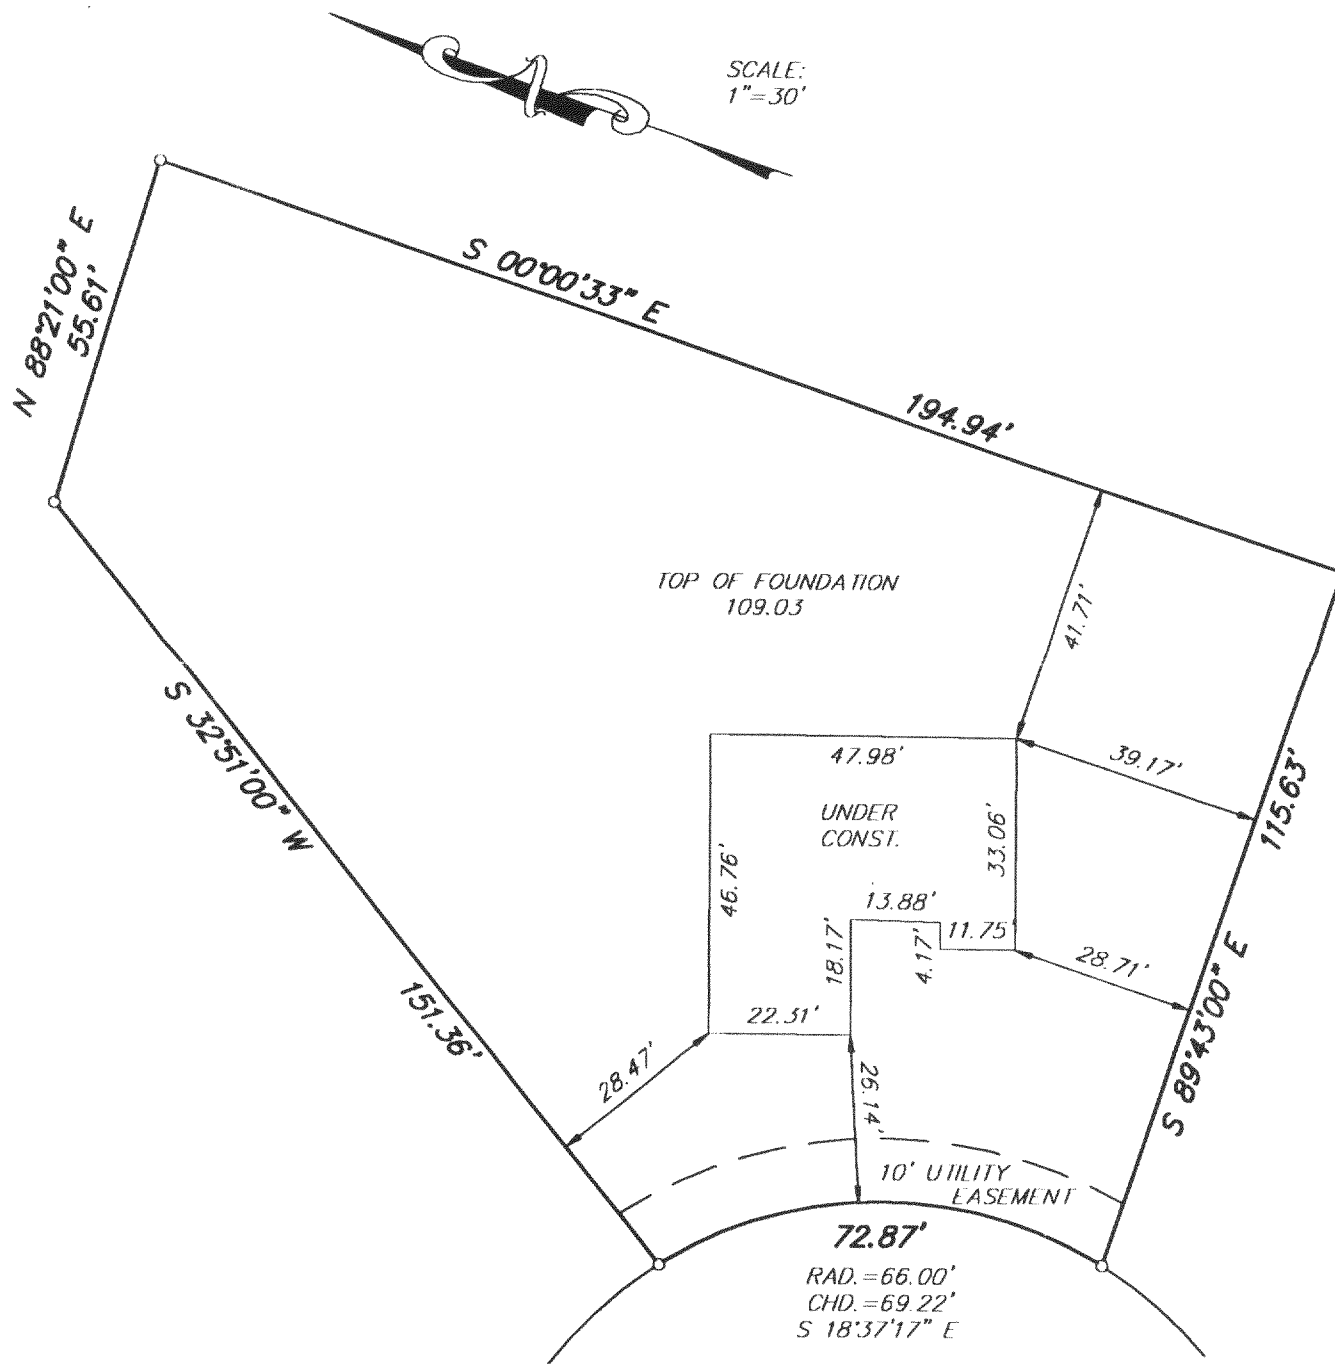


Survey No. 90672

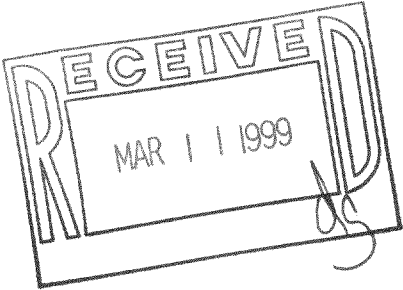

CHRISTINE COURT

A circular seal for a Wisconsin Land Surveyor. The outer ring contains the text "WISCONSIN" at the top and "LAND SURVEYOR" at the bottom, separated by two five-pointed stars. The center of the seal contains the name "GERALD E. CASEY", the number "8-1328", and the location "Greendale, WI".

SIGNED



PLAT OF SURVEY

LOCATION: 5901 Christine Court, Lyons, Wisconsin

LEGAL DESCRIPTION: Lot 21 in LYONS HILLSIDE SUBDIVISION, a subdivision located in part of the Northwest 1/4 of the Southeast 1/4 of Section 10 North, Range 18 East, Town of Lyons, County of Walworth, State of Wisconsin.

February 3, 1999

Survey No. 90214

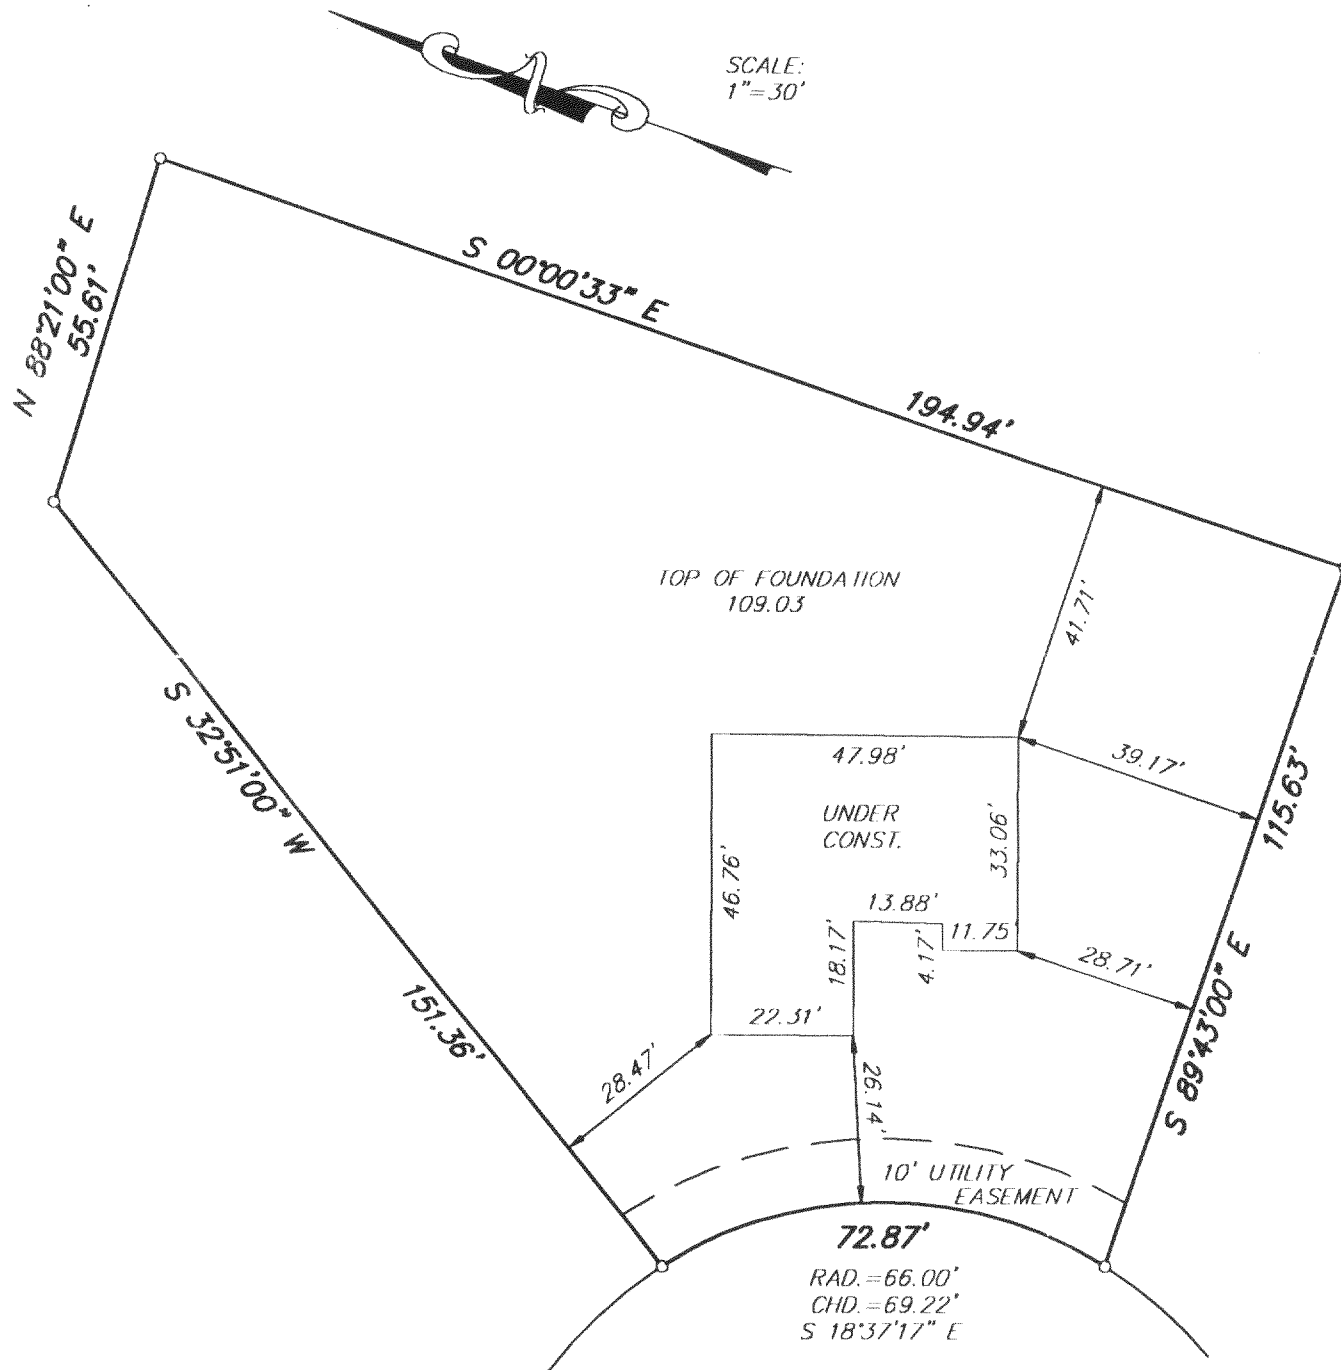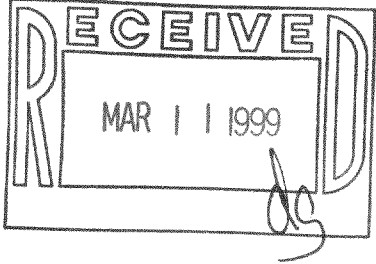

CHRISTINE COURT

METROPOLITAN SURVEY SERVICE, INC.
REGISTERED LAND SURVEYORS
9415 W. FOREST HOME AVE., SUITE 202, HALES CORNERS, WI 53130
PH. 529-5380 FAX 529-9787



I HEREBY CERTIFY THAT I HAVE SURVEYED THE ABOVE DESCRIBED PROPERTY AND THAT THE ABOVE MAP IS A TRUE REPRESENTATION THEREOF AND SHOWS THE SIZE AND LOCATION OF THE PROPERTY, ITS EXTERIOR BOUNDARIES, THE LOCATION OF ALL VISIBLE STRUCTURES AND DIMENSIONS OF ALL PRINCIPAL BUILDINGS THEREON, BOUNDARY FENCES, APPARENT EASEMENTS AND ROADWAYS AND VISIBLE ENCROACHMENTS, IF ANY.

THIS SURVEY IS MADE FOR THE EXCLUSIVE USE OF THE PRESENT OWNERS OF THE PROPERTY, AND ALSO THOSE WHO PURCHASE, MORTGAGE, OR GUARANTEE THE TITLE THERETO WITHIN ONE (1) YEAR FROM DATE HEREOF.

SIGNED

218-1037

NLH-21