

ALVIN HOWE RD.



● - IRON PIPE

NOTE:

CORNER IS IN FENCE
POST NO PIPE SET

CERTIFIED SURVEY # 440

PARCEL "A"

PARCEL "B"

DESCRIPTION:


THE EAST 14 ACRES OF THE NE 1/4 OF THE NW 1/4 OF SECTION 23,
T2N, R18E, AND LYING AND BEING IN THE TOWN OF LYONS, COUNTY
OF WALWORTH, AND STATE OF WISCONSIN.

CERTIFICATE:

I, JOSEPH M. BIAGI, SURVEYOR, DO HEREBY CERTIFY THAT I HAVE
SURVEYED THE LANDS HEREON DESCRIBED.

SIGNED:

OCTOBER 28, 1974

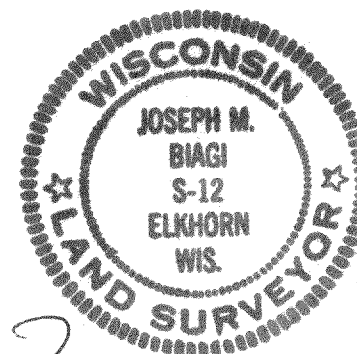

JOSEPH M. BIAGI

RLS #12

REVISIONS			MR. JOHN SCHLIMMER		
NO.	DATE	BY			
1	7/18/75	GW	THE EAST 14 ACRES OF THE NE 1/4 OF THE NW 1/4 SEC. 23-2-18		
2					
3			DRAWN BY	SCALE	MATERIAL
4			CHK'D	DATE	DRAWING NO.
5			TRACED	APP'D	