


PLAT OF SURVEY


OWNERS: THOMAS & KIMBERLY ROUCE
P.O. BOX 81
LYONS, WI. 53148

ORDERED BY: MIDWEST BUILDERS OF BURLINGTON
TIM WEILER
5152 RUEDEBUSCH RD.
BURLINGTON, WI 53105

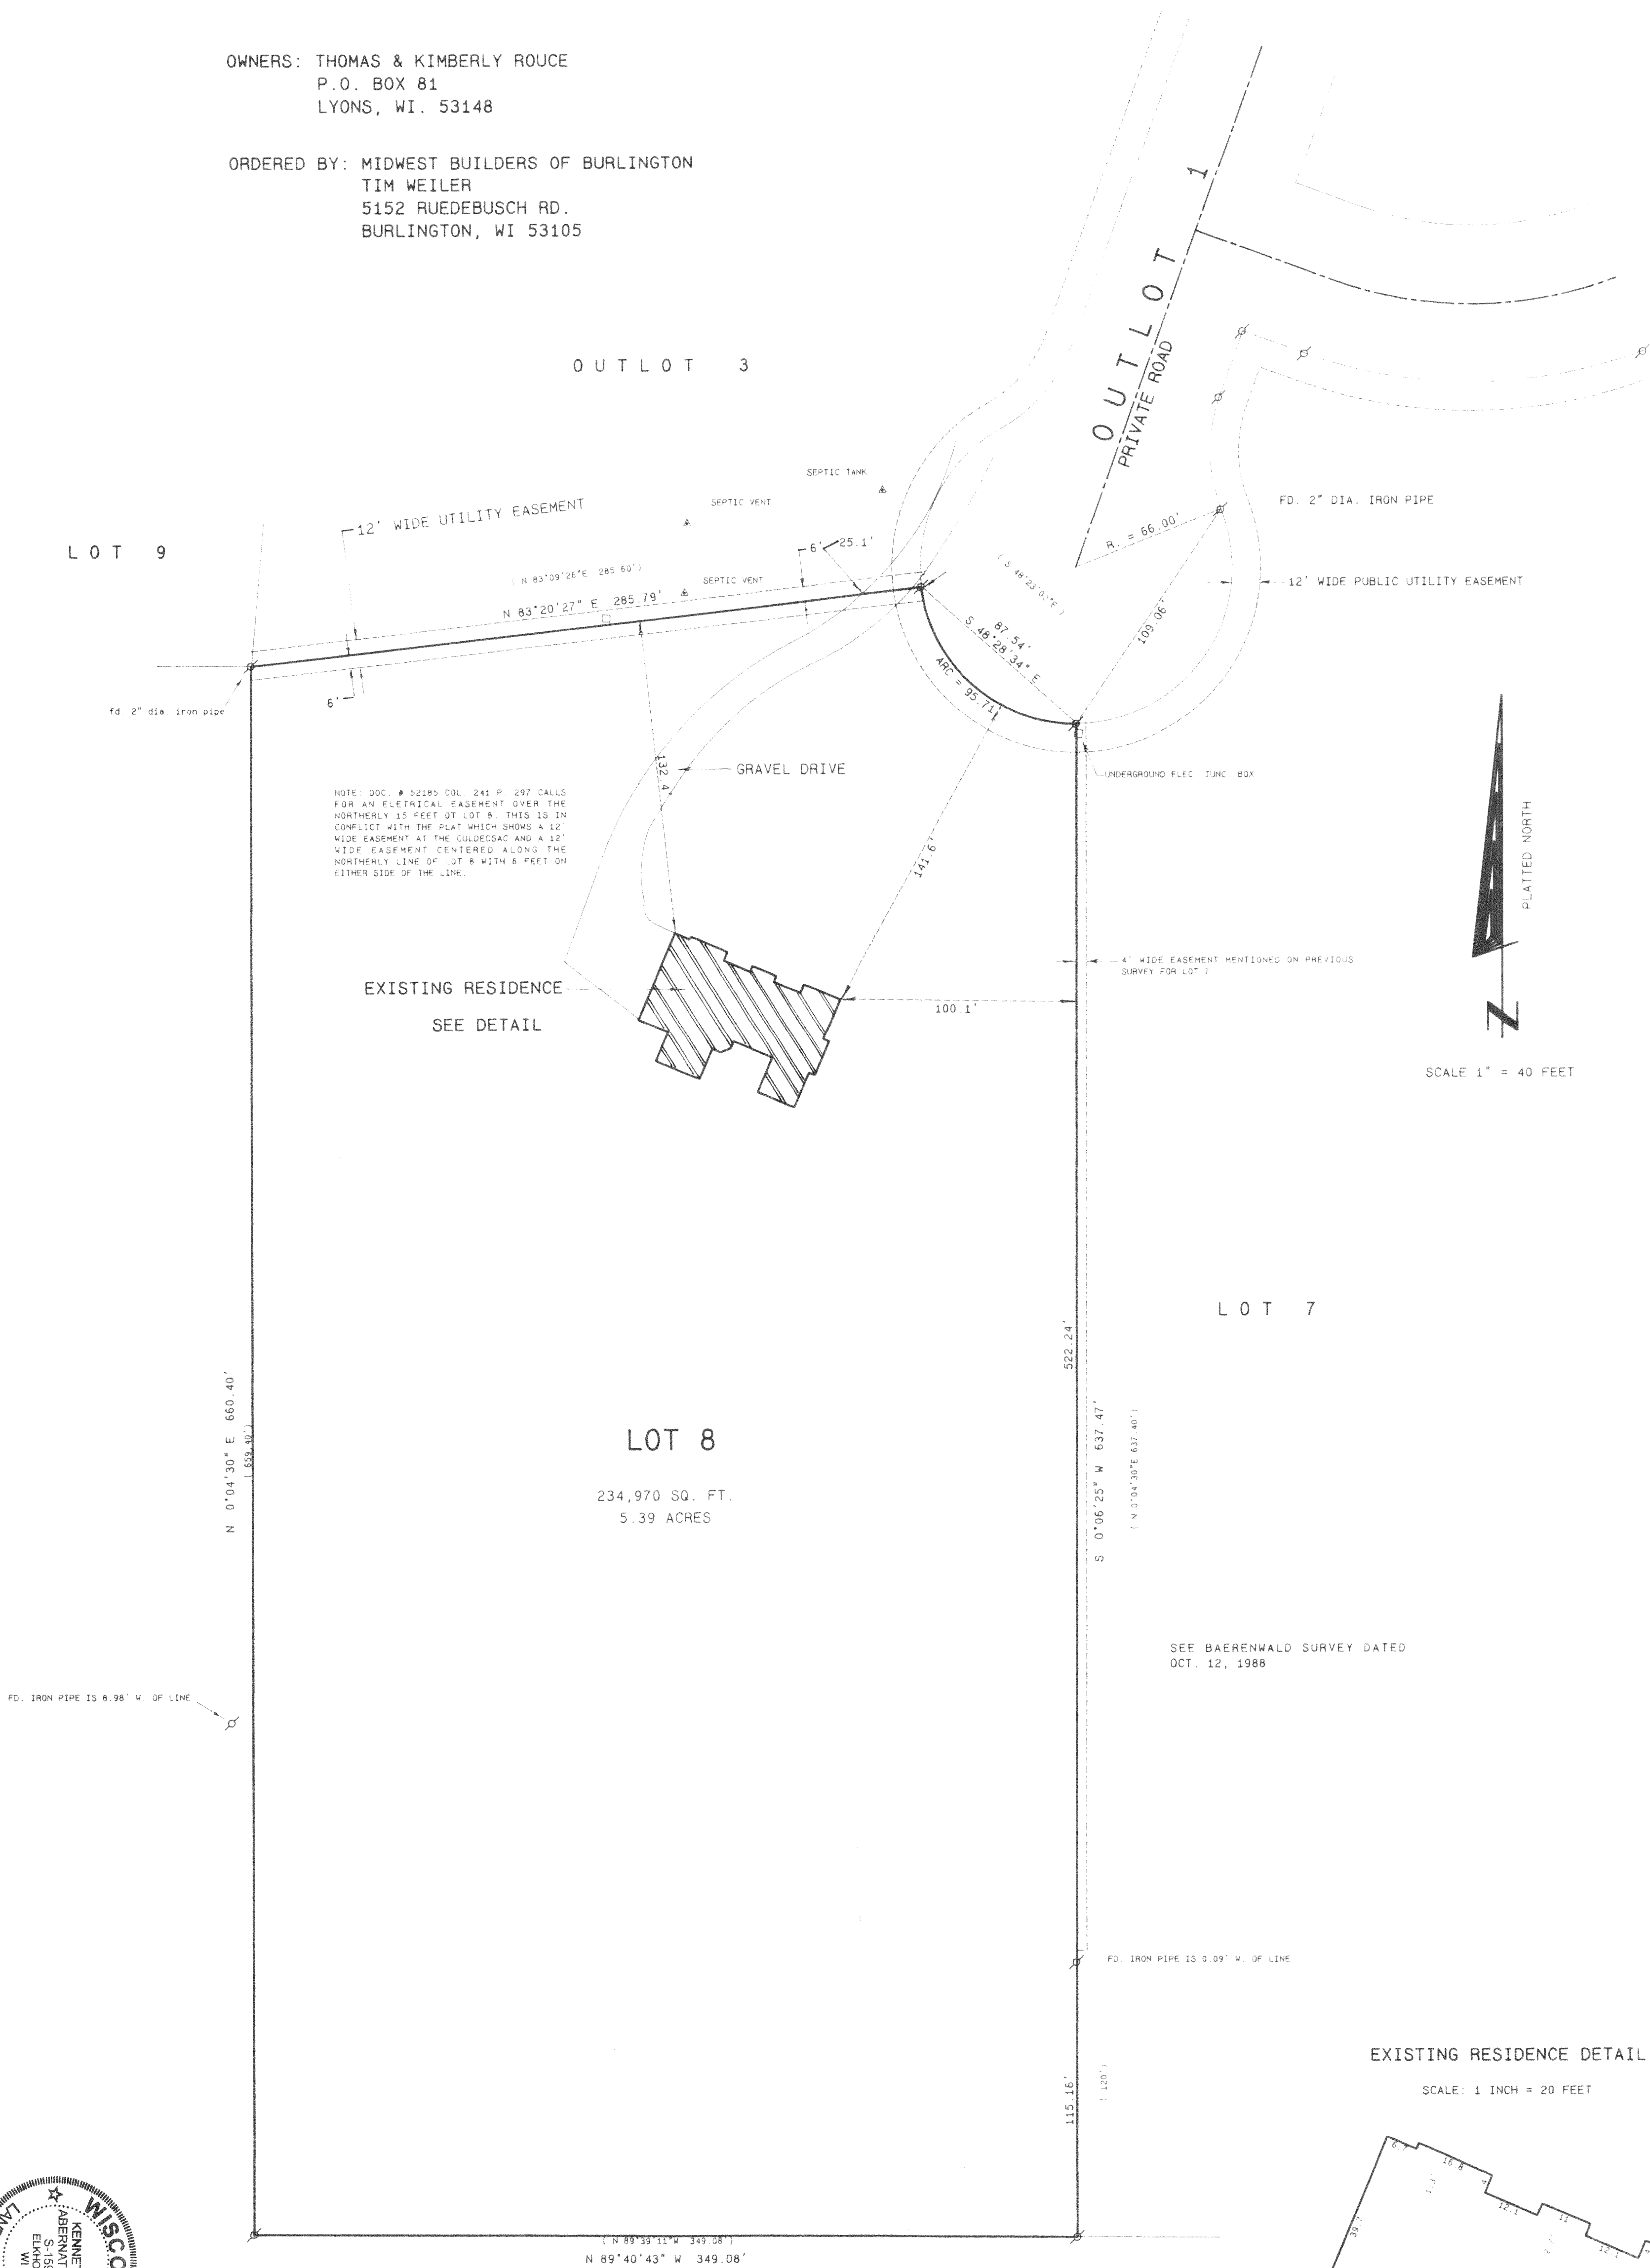

EXISTING RESIDENCE DETAIL

SCALE: 1 INCH = 20 FEET

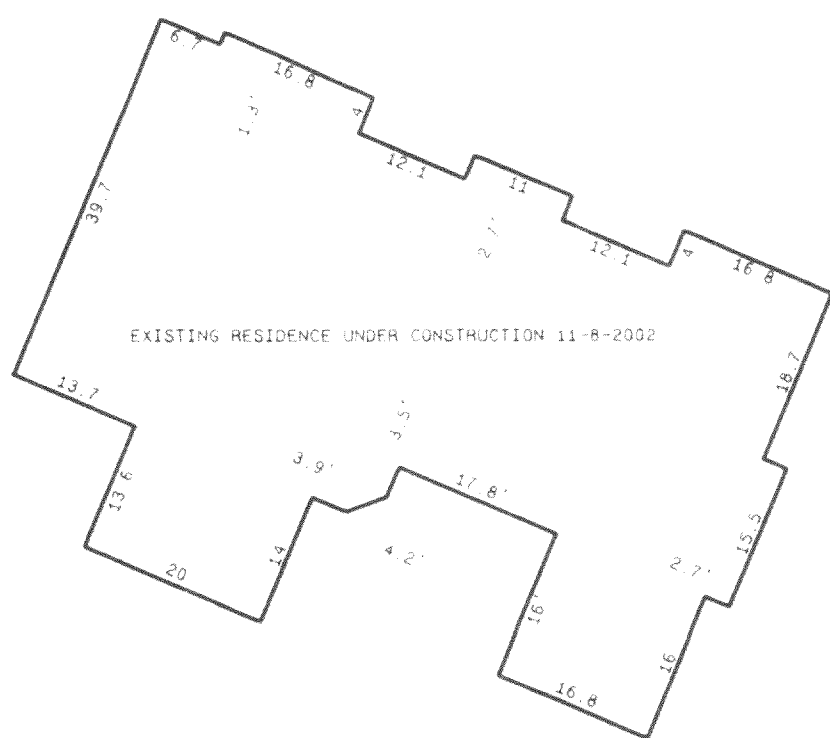

EXISTING RESIDENCE UNDER CONSTRUCTION 11-8-2002


Legend

- FOUND IRON PIPE
- FOUND IRON ROD
- FOUND BRASS CAPPED MONUMENT
- FOUND CONCRETE MONUMENT
- CHISEL CUT IN CONCRETE
- SET IRON ROD, 2" LONG, WEIGHING 15 LBS., LINEAL FT. 3 1/8" DIA.
- SET IRON ROD, 30" LONG, WEIGHING 45 LBS., LINEAL FT. 1 1/16" DIA.
- RECORDED AS DIMENSION
- EXISTING FENCE

---X---X---
EXISTING FENCE

SCALE: 1"= 40 FEET

REVISED TO SHOW PROPOSED RESIDENCE JULY 18, 2002
REVISED TO SHOW RESIDENCE "AS BUILT" NOV. 11, 2002

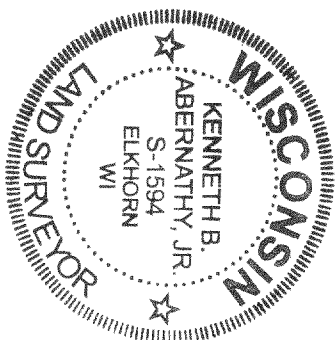

KENNETH B. ABERNATHY, JR.
 WISCONSIN REGISTERED LAND SURVEYOR
 S-1594
 Date: 8-21-78 Job No. 98807

Kenneth B. Dink