
PLAT OF SURVEY

LOCATION:

Sherwood Court, Lyons, Wisconsin

LEGAL DESCRIPTION: Lot 20 in **CRANBERRY KNOLLS**, a subdivision located in the Northeast 1/4 and Southeast 1/4 of the Northeast 1/4 of Section 36, Town 2 North, Range 18 East, in the Town of Lyons, Walworth County, Wisconsin.

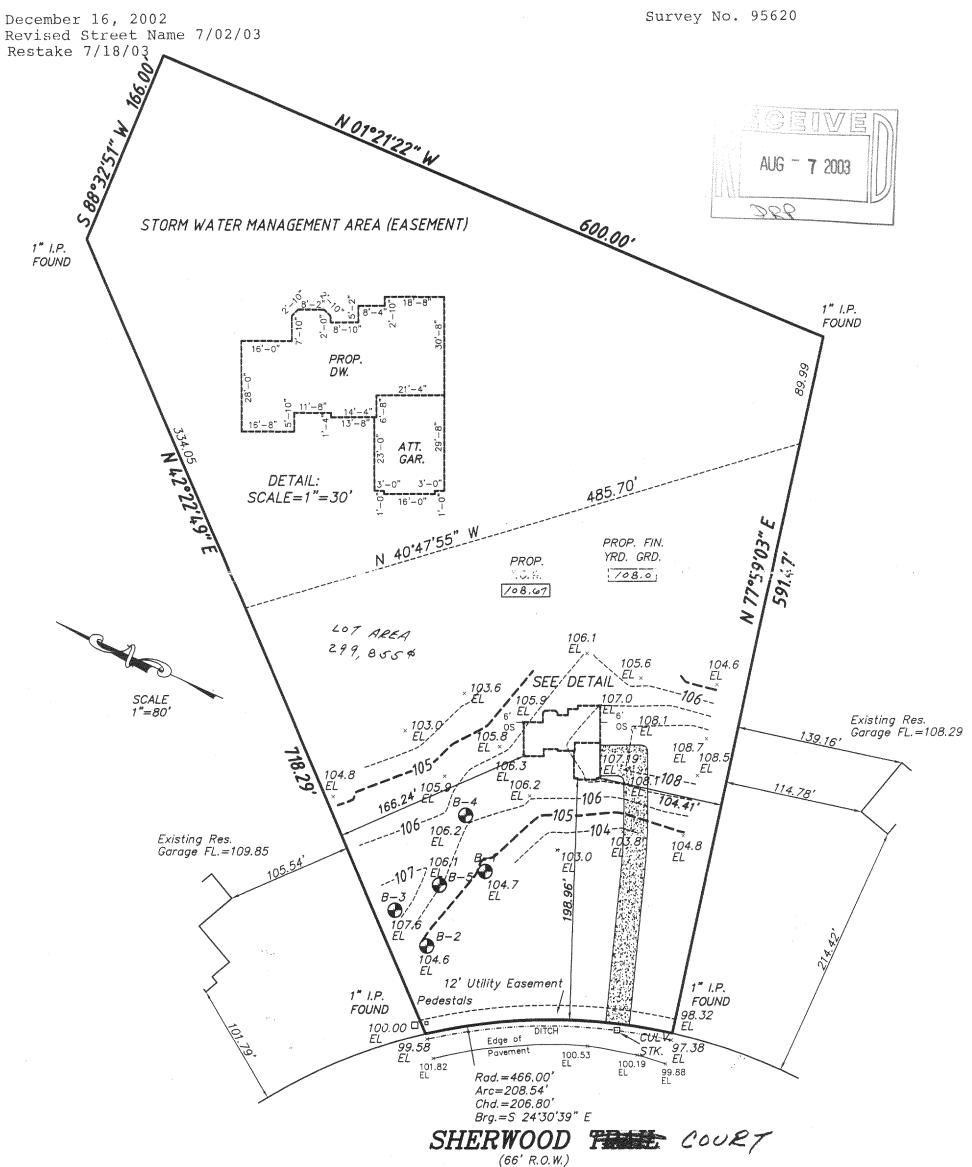

METROPOLITAN SURVEY SERVICE, INC. REGISTERED LAND SURVEYORS

5200 W. LOOMIS RD. • GREENDALE, WI 53129 PH. 529-5380 FAX 529-9787



I HEREBY CERTIFY THAT I HAVE SURVEYED THE ABOVE DESCRIBED PROPERTY AND THAT THE ABOVE MAP IS A TRUE REPRESENTATION THEREOF AND SHOWS THE SIZE AND LOCATION OF THE PROPERTY, ITS EXTERIOR BOUNDARIES, THE LOCATION OF ALL VISIBLE STRUCTURES AND DIMENSIONS OF ALL PRINCIPAL BUILDINGS THEREON, BOUNDARY FENCES, APPARENT EASEMENTS AND ROADWAYS AND VISIBLE ENCROACHMENTS, IF ANY.

THIS SURVEY IS MADE FOR THE EXCLUSIVE USE OF THE PRESENT OWNERS OF THE PROPERTY, AND ALSO THOSE WHO PURCHASE, MORTGAGE, OR GUARANTEE THE TITLE THERETO WITHIN ONE (1) YEAR FROM DATE HEREOF.



