
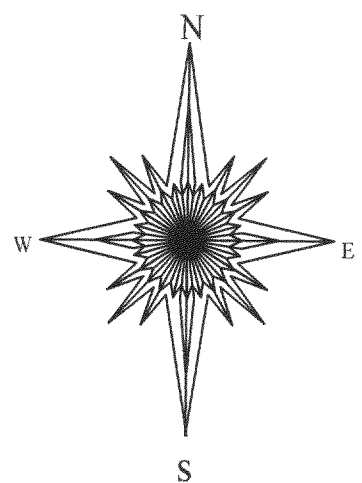


PLAT OF SURVEY

- OF -

UNIT 205 PHASE 2 OF COUNTRY ESTATES, A CONDOMINIUM, LOCATED IN THE NORTHWEST 1/4 OF SECTION 8 AND THE EAST 1/2 OF THE NORTHEAST 1/4 OF SECTION 7, TOWN 2 NORTH, RANGE 18 EAST, WALWORTH COUNTY, WISCONSIN.

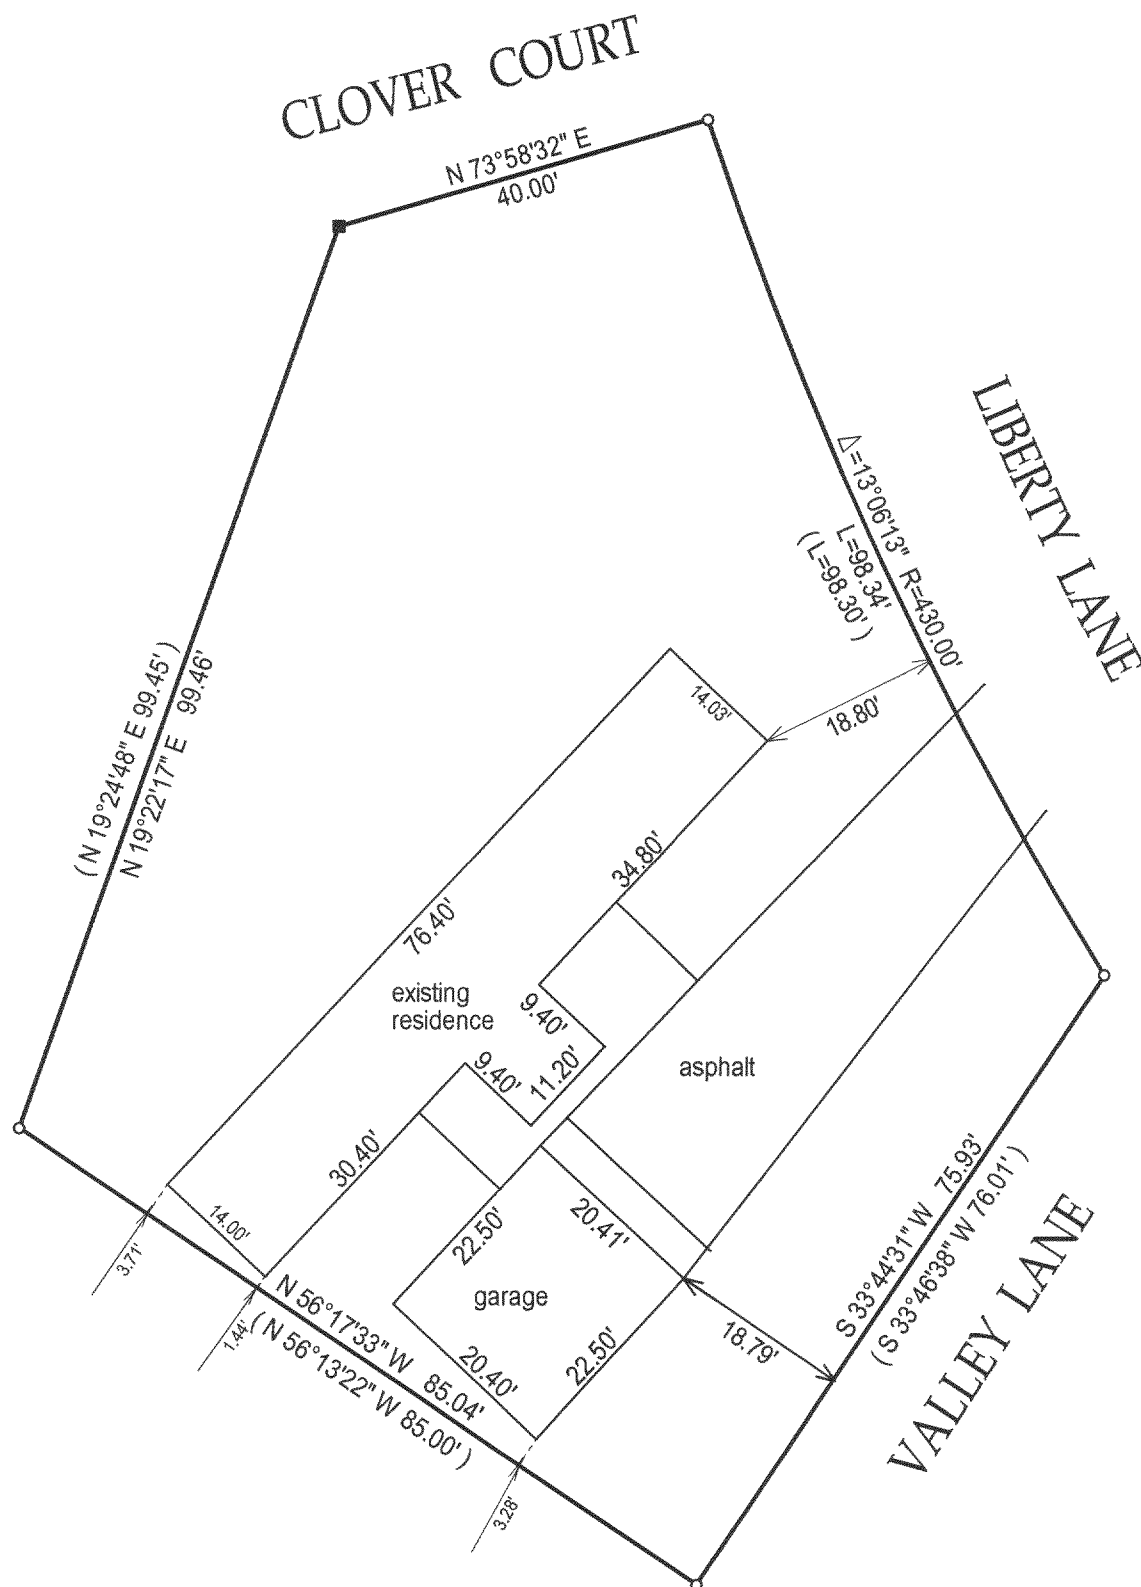


- ☐ = found iron bar
- ☐ = found iron pipe
- ☒ = set iron pipe
- ☒ = set iron bar

NCS 00205

This survey is made for the present owners of the property, and those who purchase, mortgage, or guarantee the title thereto, within one year from the date hereof.

DATED THIS 28 TH, DAY OF MAY 20 03

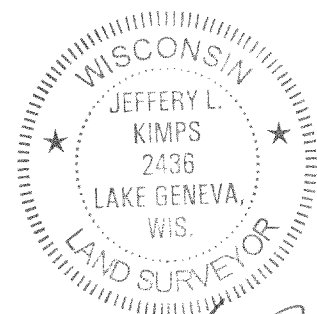

JEFFREY L KIMPS S-2436
Wisconsin Registered Land Surveyor
(original if signed in red)

218-1412