

- OF -

J.K. SURVEYING INC.
N3705 WILLOWBEND LANE
LAKE GENEVA, WI 53147
(262) 248-3697

LOT 1

LOT 2

LOT 3

GAIL LYNNE DRIVE
(66' WIDE)

UNPLATTED LAND

EXISTING RESIDENCE

DECK

WELL

PROpane TANK

4" VENT

PAVEMENT DRIVE

CONCRETE

CONCRETE STUOP


UTILITY EASEMENT


Dimensions:

- Top Boundary: $N 89^{\circ}22'41'' W$, $(S 89^{\circ}22'37'' E \ 333.38')$, $333.24'$
- Right Boundary: $N 00^{\circ}18'42'' W$, $(N 0^{\circ}17'18'' W \ 300.00')$, $299.98'$
- Bottom Boundary: $S 89^{\circ}22'37'' E \ 333.38'$, $S 89^{\circ}22'20'' E$, $333.36'$
- Left Boundary: $299.95'$, $(300.00')$, $S 00^{\circ}17'18'' E$
- Internal Dimensions: $157.68'$, $106.36'$, $25.43'$, $26.37'$, $26.73'$, $41.55'$, $27.20'$, $73.62'$, $195.87'$

TAX ID # NZA 00002

"I hereby certify that I have surveyed the above described property and that the above map, to the best of my knowledge and belief, is a true representation thereof and shows the size and location of all visible structures, apparent easements and encroachments if any." This survey is made for the present owners of the property, and those who purchase, mortgage, or guarantee the title thereto, within one year from the date hereof.

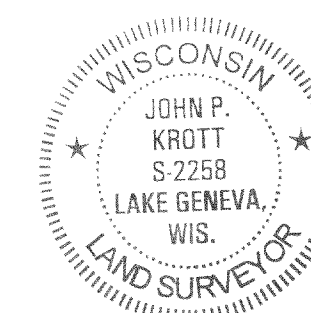


JOHN KROTT S - 2258
Wisconsin Registered Land Surveyor
(original if signed in red)

DATED THIS 25TH, DAY OF FEBRUARY 2004.

218-1442