


PLAT OF SURVEY


- OF -


8MF

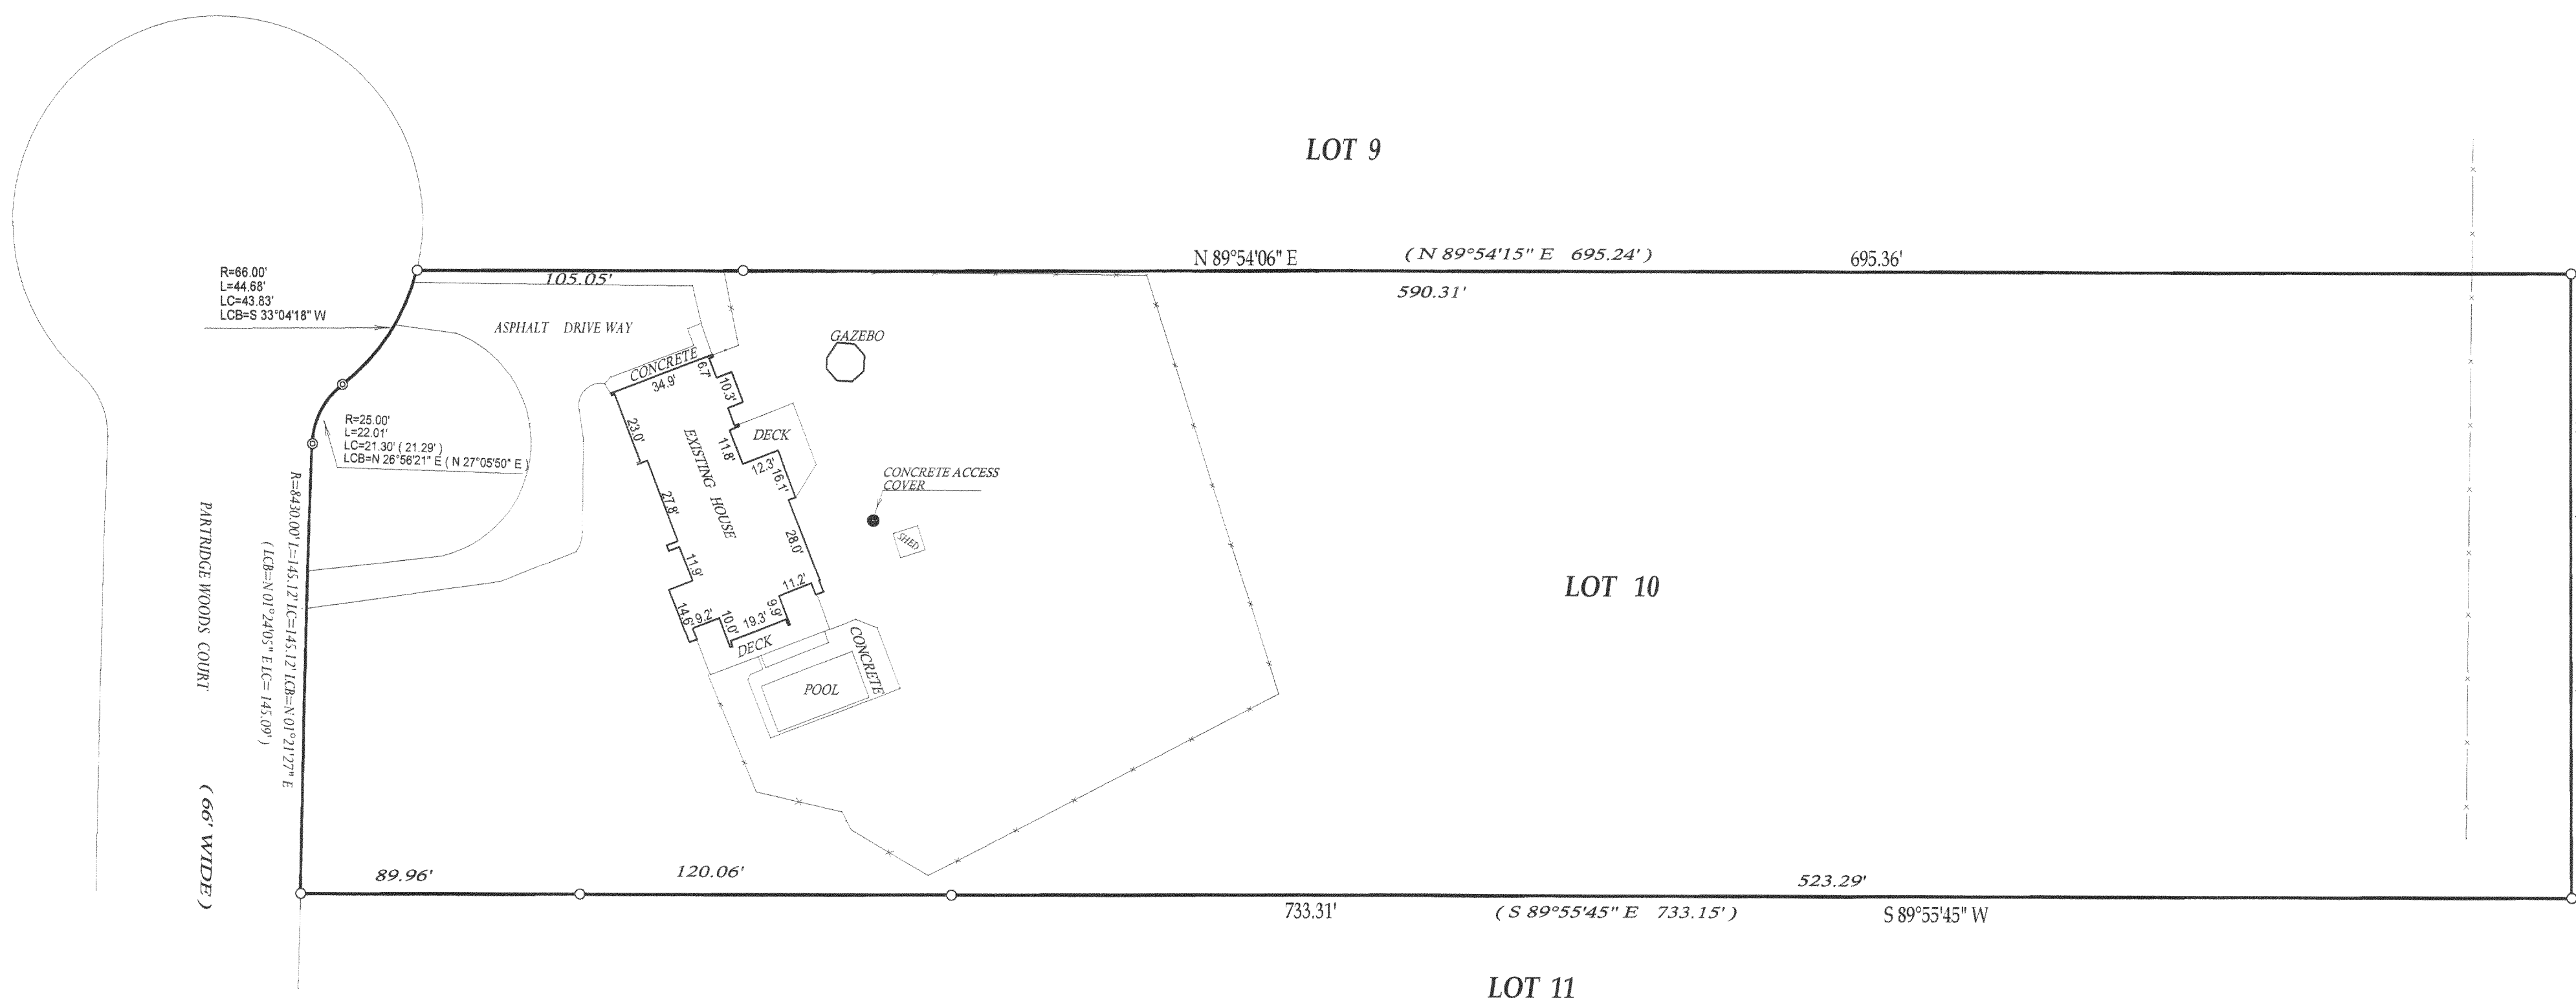

TAX ID # NPRW00010

DATED THIS 28th, DAY OF DECEMBER, 2005

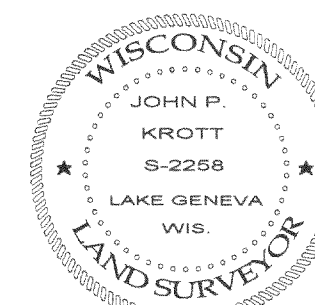



JOHN KROTT S - 2258
Wisconsin Registered Land Surveyor
(original if signed in red)

218-1576