

PREPARED FOR
CHRISTINE GRALAK
6331 W. 1st AVE,
LAKE GENEVA WI. 53147





PLAT OF SURVEY

-OF-

LOT 28 IN CLEAR VIEW ESTATES, A SUBDIVISION
LOCATED IN THE NORTHEAST 1/4 OF SECTION 33,
TOWN 2 NORTH, RANGE 18 EAST, LYING AND BEING
IN THE COUNTY OF WALWORTH AND STATE OF
WISCONSIN.

KROTT SURVEYING INC.

N3705 WILLOW BEND LANE
LAKE GENEVA WI. 53147
PHONE # (262)248-3697
FAX # (262)249-0639

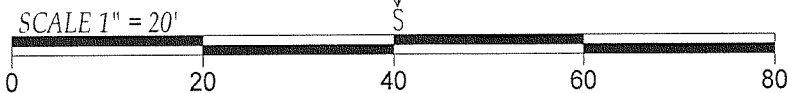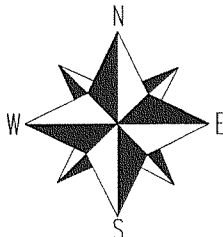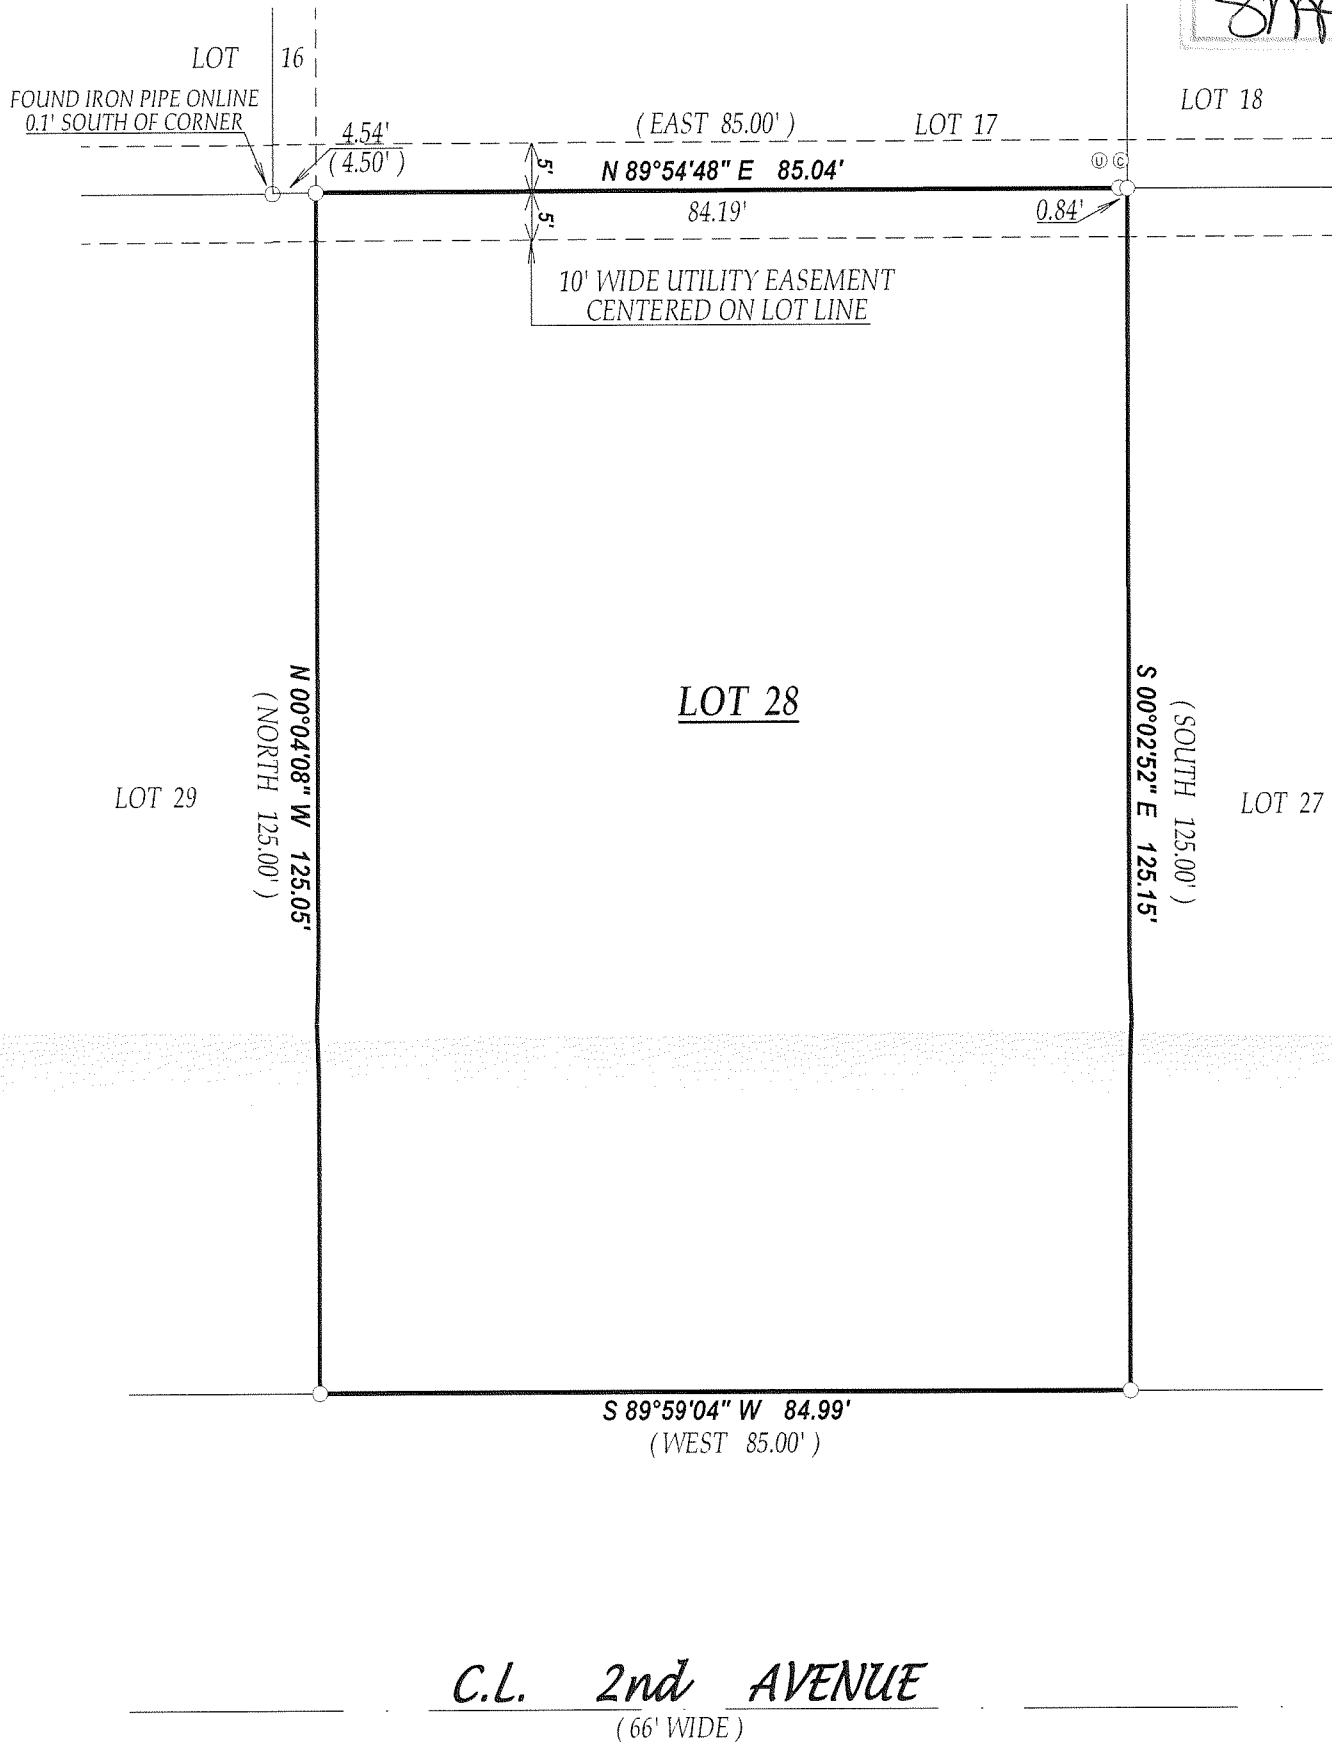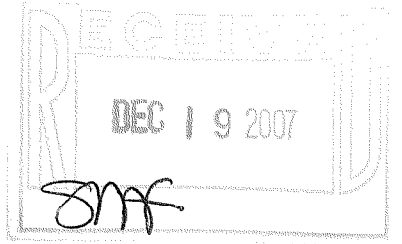

LEGEND

- FOUND IRON PIPE
- ◎ CABLE PEDISTAL
- ⊙ UTILITY PEDISTAL

(XX) RECORDED AS

JOB # 07-511 TAX ID # NCL00028
DATED THIS THE 29th DAY OF OCTOBER 2007.

COMPARE LEGAL DESCRIPTION ABOVE AND DRAWING WITH DEED.
FOR BUILDING RESTRICTIONS AND EASEMENTS NOT SHOWN, REFER
TO DEED, ABSTRACT SOURCES AND LOCAL MUNICIPAL CODES. NOTIFY
THE SURVEYOR IMMEDIATELY OF ANY DISCREPANCY.

"I hereby certify that I have surveyed the above described property and that
the above map is a true representation thereof and shows the size and
location of all visible structures, apparent easements and encroachments
if any."

This survey is made for the present owners of the property, and those who
purchase, mortgage, or guarantee the title thereto, within one year from
the date hereof.



John P. Krott
JOHN KROTT S - 2258
Wisconsin Registered Land Surveyor
(original if signed in red)

218-1666