

**FARRIS, HANSEN & ASSOCIATES, INC.**  
ENGINEERING — ARCHITECTURE — SURVEYING  
7 RIDGWAY COURT P.O. BOX 437  
ELKHORN, WISCONSIN 53121  
OFFICE: (262) 723-2098 FAX: (262) 723-5886



## REVISIONS

PROJECT NO.	8012
DATE:	09-30-2009
SHEET NO.	1 OF 1

3. The land referred to in the Commitment is described as follows:

Lot 4 of Meadow Hill Farms, as recorded in the office of the Register of Deeds for Walworth County, Wisconsin in Cabinet "B" of Plats, Slide 41, said subdivision being a part of the South 1/2 of the Southeast 1/4 of Section 32, T2N, R18E, Town of Lyons, County of Walworth, State of Wisconsin.

Tax Key No: NMH 00004

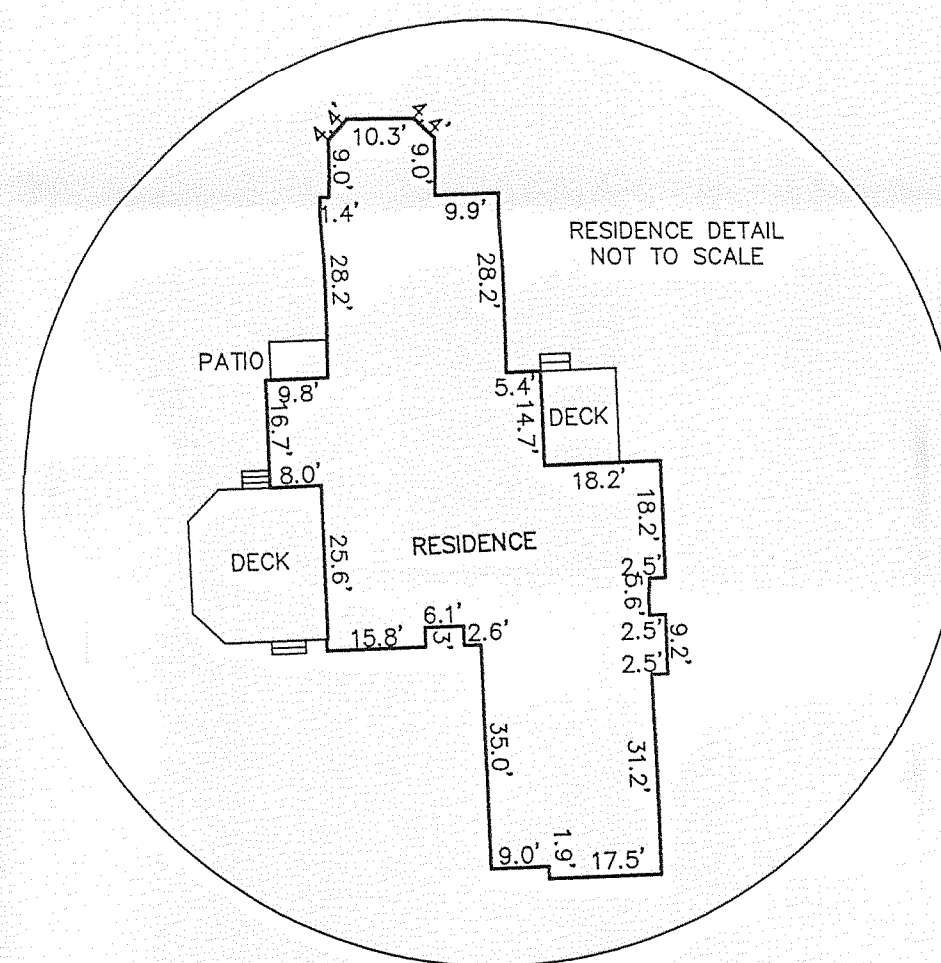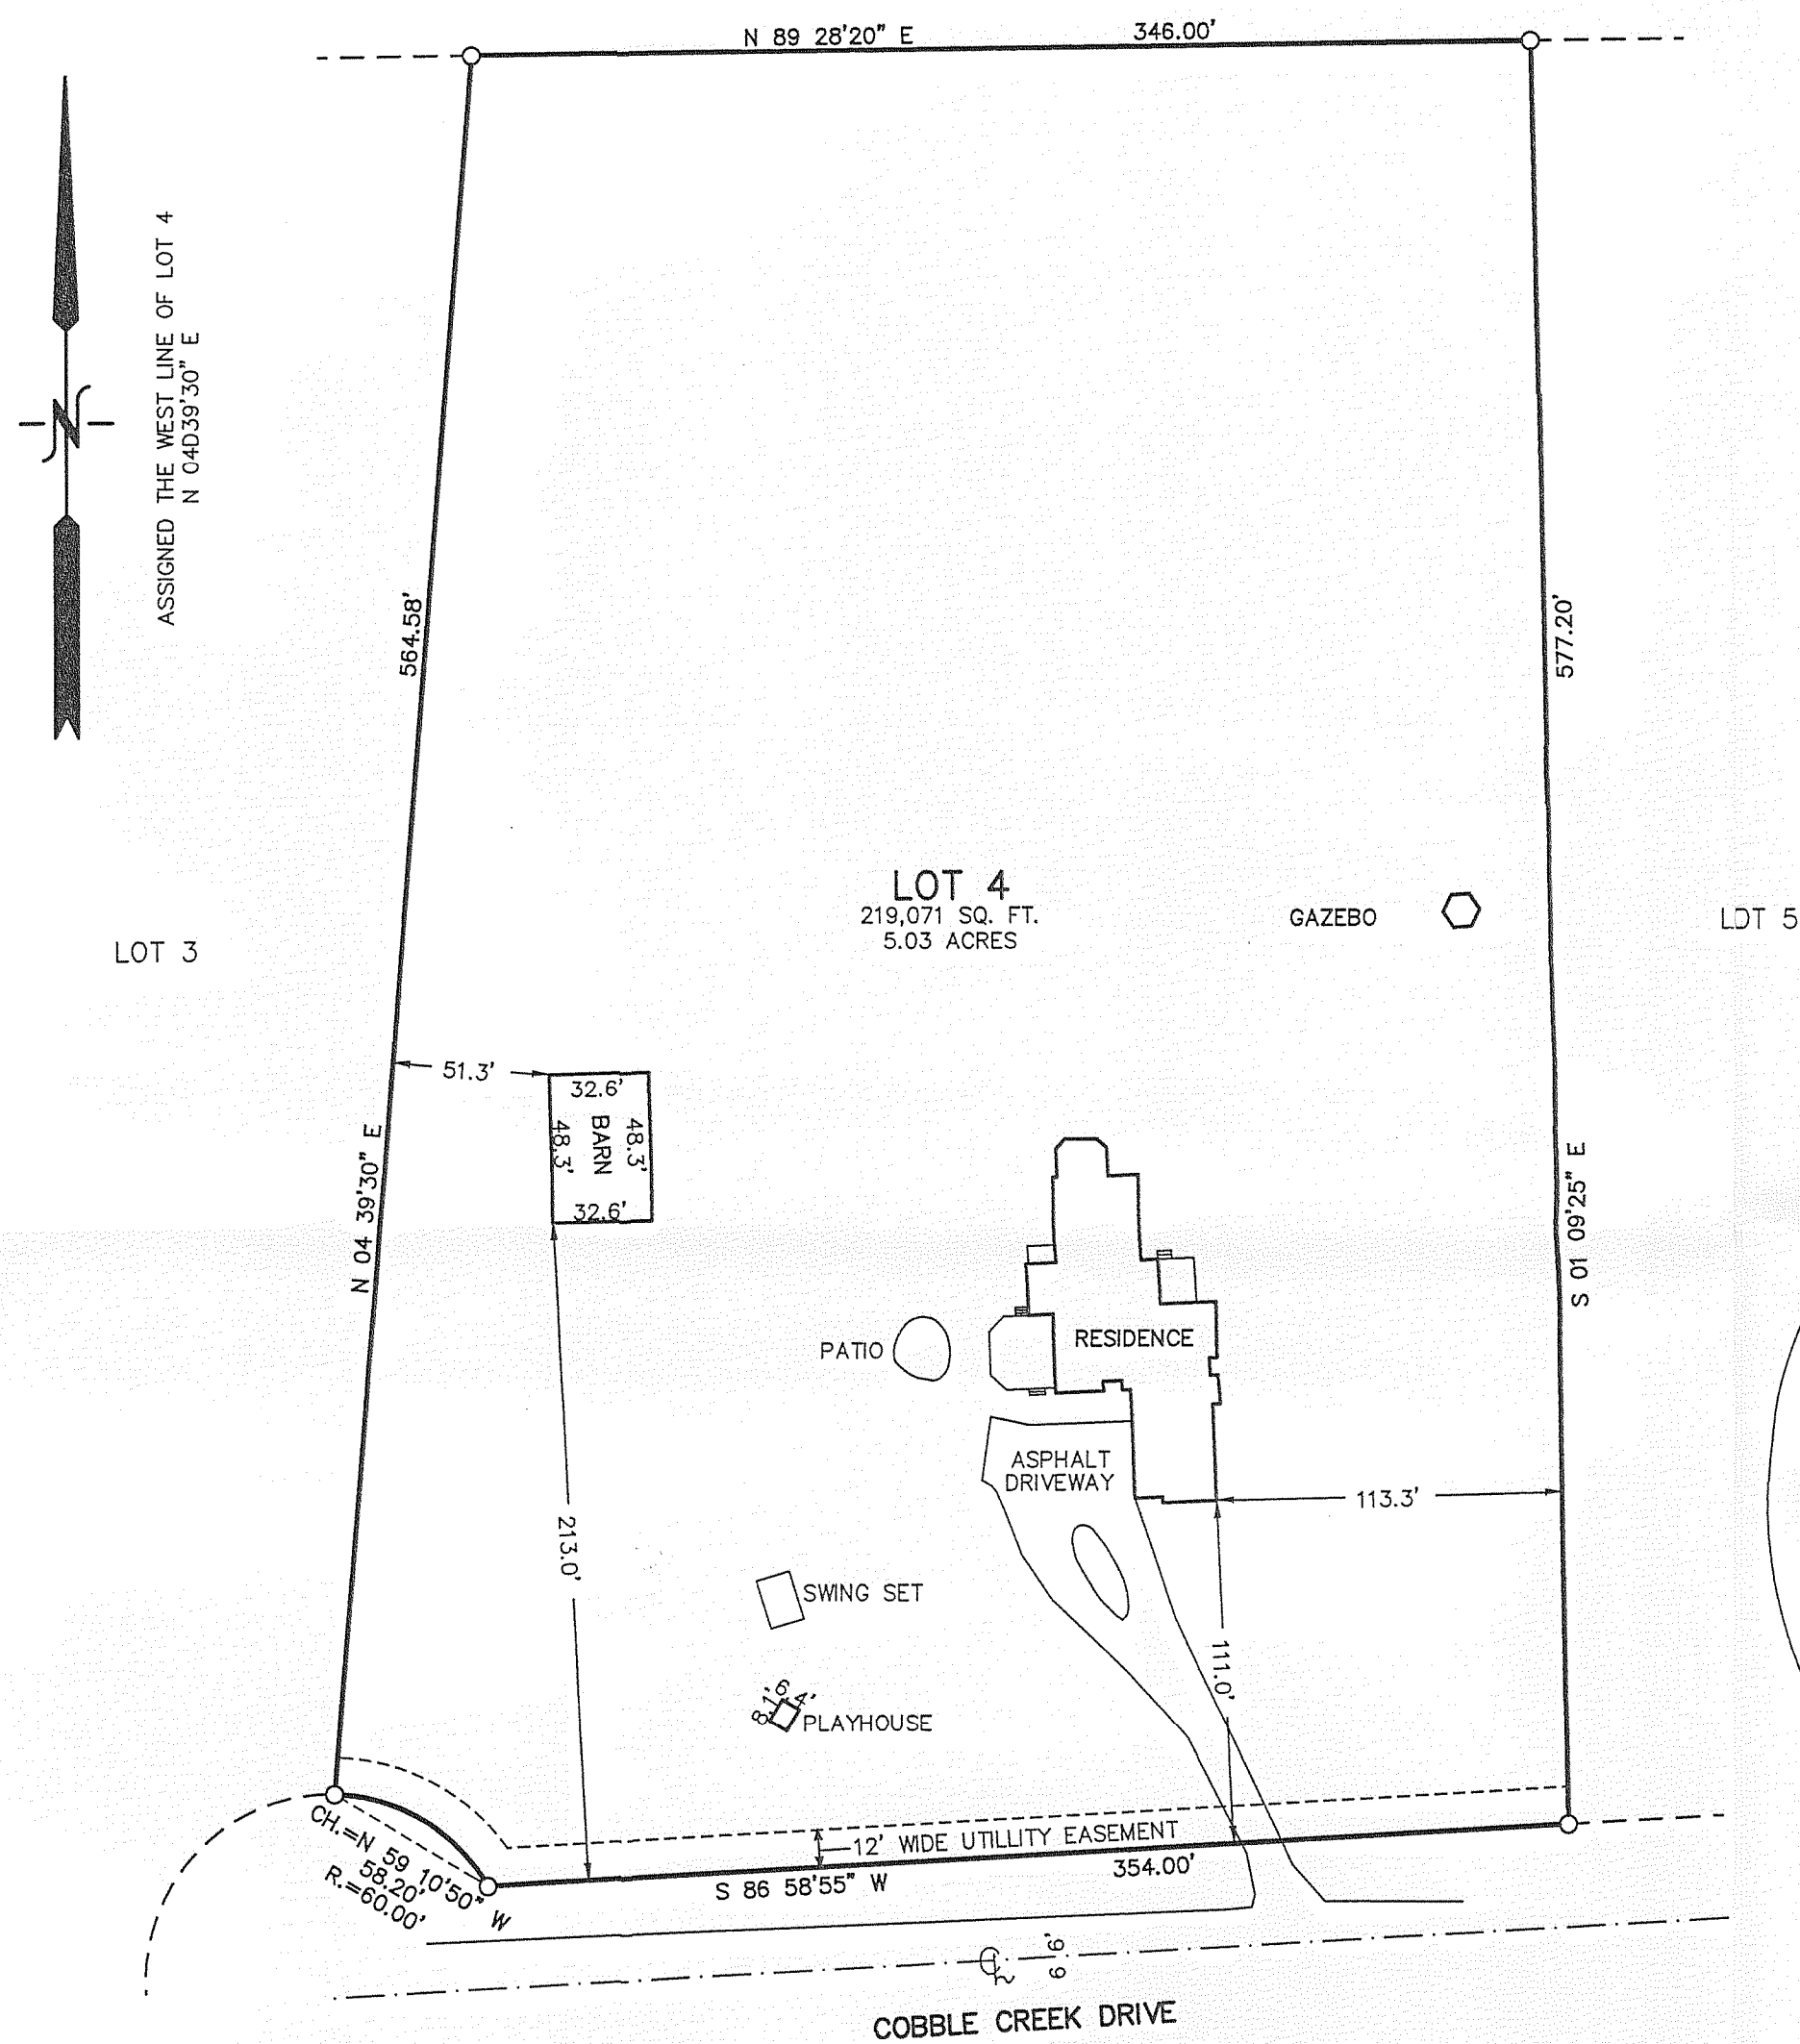


LEGEND  
○ = FOUND IRON PIPE STAKE  
(XXX) = RECORDED AS

SURVEYOR'S NOTE:  
EASEMENT TO W. POWER & LIGHT CO. RECORDED AS DOC. 320850  
ALLOWS FOR POLES AND APPURTENANCES TO BE RUN WITHIN THE BOUNDARIES  
OF THE SUBJECT PROPERTY WITH NO SPECIFIC EASEMENT LOCATION OR WIDTH.



NOTE: COPIES OF THIS MAP TO WHICH THE FOLLOWING CERTIFICATE WILL APPLY SHOW SURVEYOR'S ORIGINAL SEAL AND SIGNATURE IN RED INK. COPIES BY ANY OTHER MEANS MAY HAVE ALTERATIONS WHICH DO NOT REPRESENT THE SURVEYOR'S WORK PRODUCT.

I HEREBY CERTIFY THAT THE ABOVE DESCRIBED PROPERTY HAS BEEN SURVEYED UNDER MY DIRECTION AND THAT THE ABOVE MAP IS A TRUE REPRESENTATION THEREOF AND SHOWS THE SIZE AND LOCATION OF THE PROPERTY, ITS EXTERIOR BOUNDARIES, THE LOCATION OF ALL VISIBLE STRUCTURES, AND DIMENSIONS OF ALL PRINCIPLE BUILDINGS THEREON, BOUNDARY FENCES, APPARENT EASEMENTS, ROADWAYS, AND VISIBLE ENCROACHMENTS, IF ANY. THIS SURVEY IS MADE FOR THE USE OF THE PRESENT OWNERS OF THE PROPERTY, AND ALSO THOSE WHO PURCHASE, MORTGAGE, OR GUARANTEE THE TITLE THERETO WITHIN ONE YEAR FROM THE DATE HEREOF.

DATED: SEPTEMBER 30, 2009

  
PETER S. GORDON R.L.S. 2101

MAP SCALE IN FEET ORIGINAL 1" = 60'

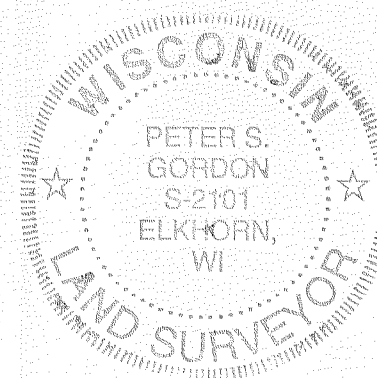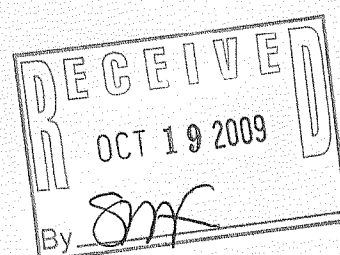

NMH-4

218-1730