PLAT OF SURVEY


LOT 2 OF CSM 3256 LOCATED IN THE SW 1/4 OF THE SW 1/4 OF SECTION 18 TOWN 2 NORTH, RANGE 18 EAST WALWORTH COUNTY, WISCONSIN



LEGEND

O = FOUND IRON PIPE STAKE

(XXX) = RECORDED AS

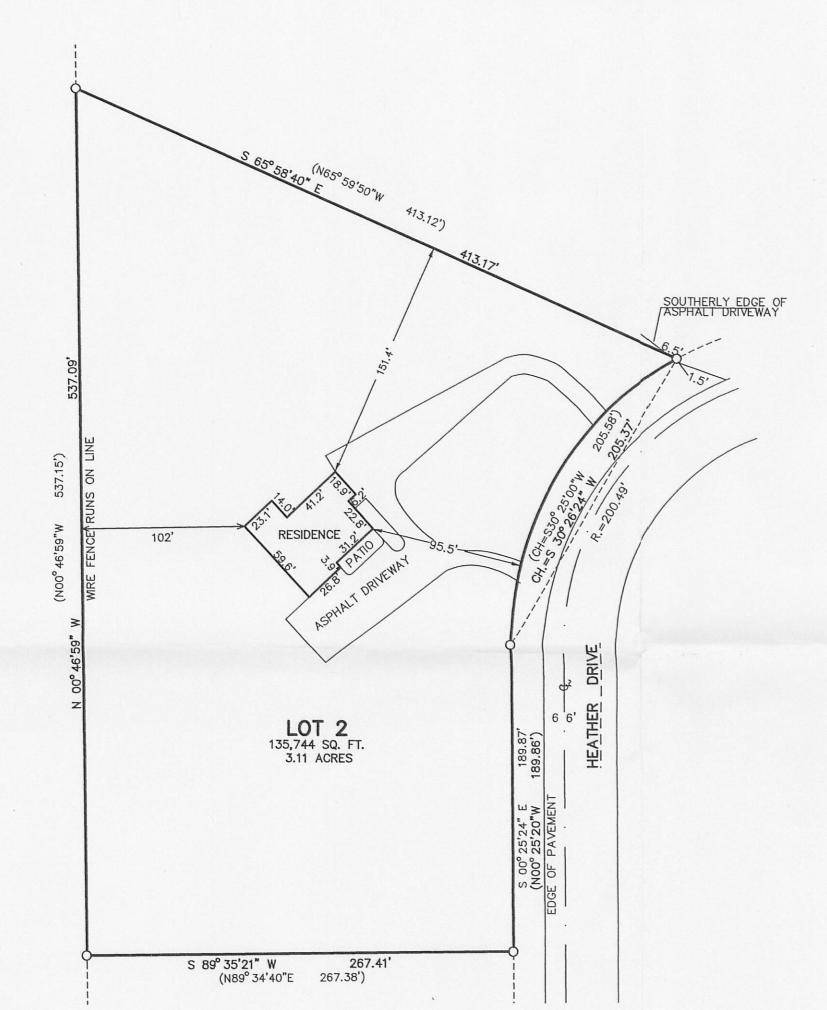

3. The land referred to in the Commitment is described as follows:

Lot 2 of Certified Survey Map No. 3256 according to the recorded plat thereof, recorded in Volume 18 of Certified Surveys on Page 135 as Document No. 452164 located in the Southwest 1/4 of the Southwest 1/4 of Section 18, Town 2 North, Range 18 East. Said land being in the Town of Lyons, County of Walworth, State of Wisconsin.

Property Address: 2148 Heather Drive, Lake Geneva, WI 53147

Tax Key Number: NA325600002

FARRIS, HANSEN & ASSOCIATES, INC.
ENGINEERING — ARCHITECTURE — SURVEYING
7 RIDGWAY COURT P.O. BOX 437
ELKHORN, WSCONSIN 53121
OFFICE: (262) 723–2098 FAX: (262) 723–5886

REVISIONS

NOTE: COPIES OF THIS MAP TO WHICH THE FOLLOWING CERTIFICATE WILL APPLY SHOW SURVEYOR'S ORIGINAL SEAL AND SIGNATURE IN RED INK. COPIES BY ANY OTHER MEANS MAY HAVE ALTERATIONS WHICH DO NOT REPRESENT THE SURVEYOR'S WORK PRODUCT.

I HEREBY CERTIFY THAT THE ABOVE DESCRIBED PROPERTY HAS BEEN SURVEYED UNDER MY DIRECTION AND THAT THE ABOVE MAP IS A TRUE REPRESENTATION THEREOF AND SHOWS THE SIZE AND LOCATION OF THE PROPERTY, ITS EXTERIOR BOUNDARIES, THE LOCATION OF ALL VISIBLE STRUCTURES, AND DIMENSIONS OF ALL PRINCIPLE BUILDINGS THEREON, BOUNDARY FENCES, APPARENT EASEMENTS, ROADWAYS, AND VISIBLE ENCROACHMENTS, IF ANY. THIS SURVEY IS MADE FOR THE USE OF THE PRESENT OWNERS OF THE PROPERTY, AND ALSO THOSE WHO PURCHASE, MORTGAGE, OR GUARANTEE THE TITLE THERETO WITHIN ONE YEAR FROM THE DATE HEREOF.

DATED: AUGUST 6, 2010

PETER S. GORDON R.L.S. 2101

200 100 100 150 MAP SCALE IN FEET ORIGINAL 1" = 60'

PETER S. GORDON S-2101 ELKHORN,

NA32570-2

218-1748

PROJECT NO. 8207 DATE:

08-06-2010 SHEET NO. 1 OF 1