

PREPARED FOR
BORDER CARPENTRY
N2623 SCHOFIELD RD.
LAKE GENEVA WI. 53147


PLAT OF SURVEY

-OF-

LOT 19 IN GENEVA TERRITORY FIRST ADDITION, A SUBDIVISION
LOCATED IN THE SOUTHWEST 1/4 OF SECTION 28, THE SOUTHEAST
1/4 OF SECTION 29, THE NORTHEAST 1/4 OF SECTION 32, TOWN 2
NORTH, RANGE 18 EAST, WALWORTH COUNTY, WISCONSIN.

KROTT SURVEYING INC.

N3705 WILLOW BEND LANE
LAKE GENEVA WI. 53147
PHONE # (262)248-3697
FAX # (262)249-0639

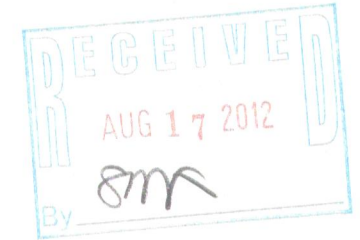

LOT 18

LOT 19

LOT 20


LEGEND

- FOUND IRON PIPE
- △ FOUND P.K. NAIL
- ⊙ UTILITY PEDESTALS
- ⊙ CABLE PEDESTAL
- ⊙ WELL
- ⊙ VENT
- ⊕ CONCRETE LID

(XX) RECORDED AS
TAX ID # NDA100008
JOB # 12-058

I have surveyed the above-described property and the above map is
a true representation thereof and shows the size and location of the
property, its exterior boundaries, the location and dimensions of all
structures thereon, fences, apparent easements and roadways and
visible encroachments, if any.

This survey is made for the exclusive use of the present owners of
the property, and also those who purchase, mortgage, or insure the
title thereto within one (1) year from date hereof; and as to them I
warrant the accuracy of said survey map.

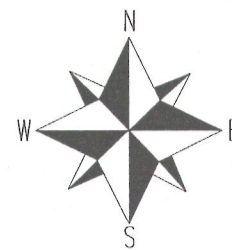

SCALE 1"=20'

0 20 40 60
NOTE: BEARINGS ARE REFERENCED TO THE RECORD PLAT

C.L. LAKESIDE ROAD
(33' WIDE)



DATED THIS 21st DAY OF MAY 2012.

John P. Krott
JOHN KROTT S - 2258
Wisconsin Registered Land Surveyor
(original if signed in red)

218-1804