
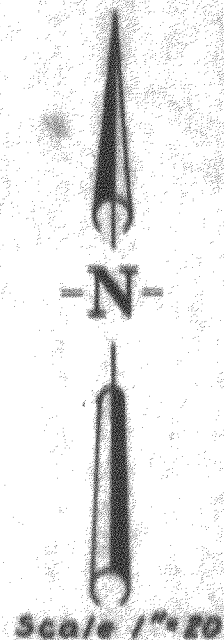


HAROLD H. KOLB  
REGISTERED PROFESSIONAL LAND SURVEYOR  
LAKE GENEVA, WISCONSIN

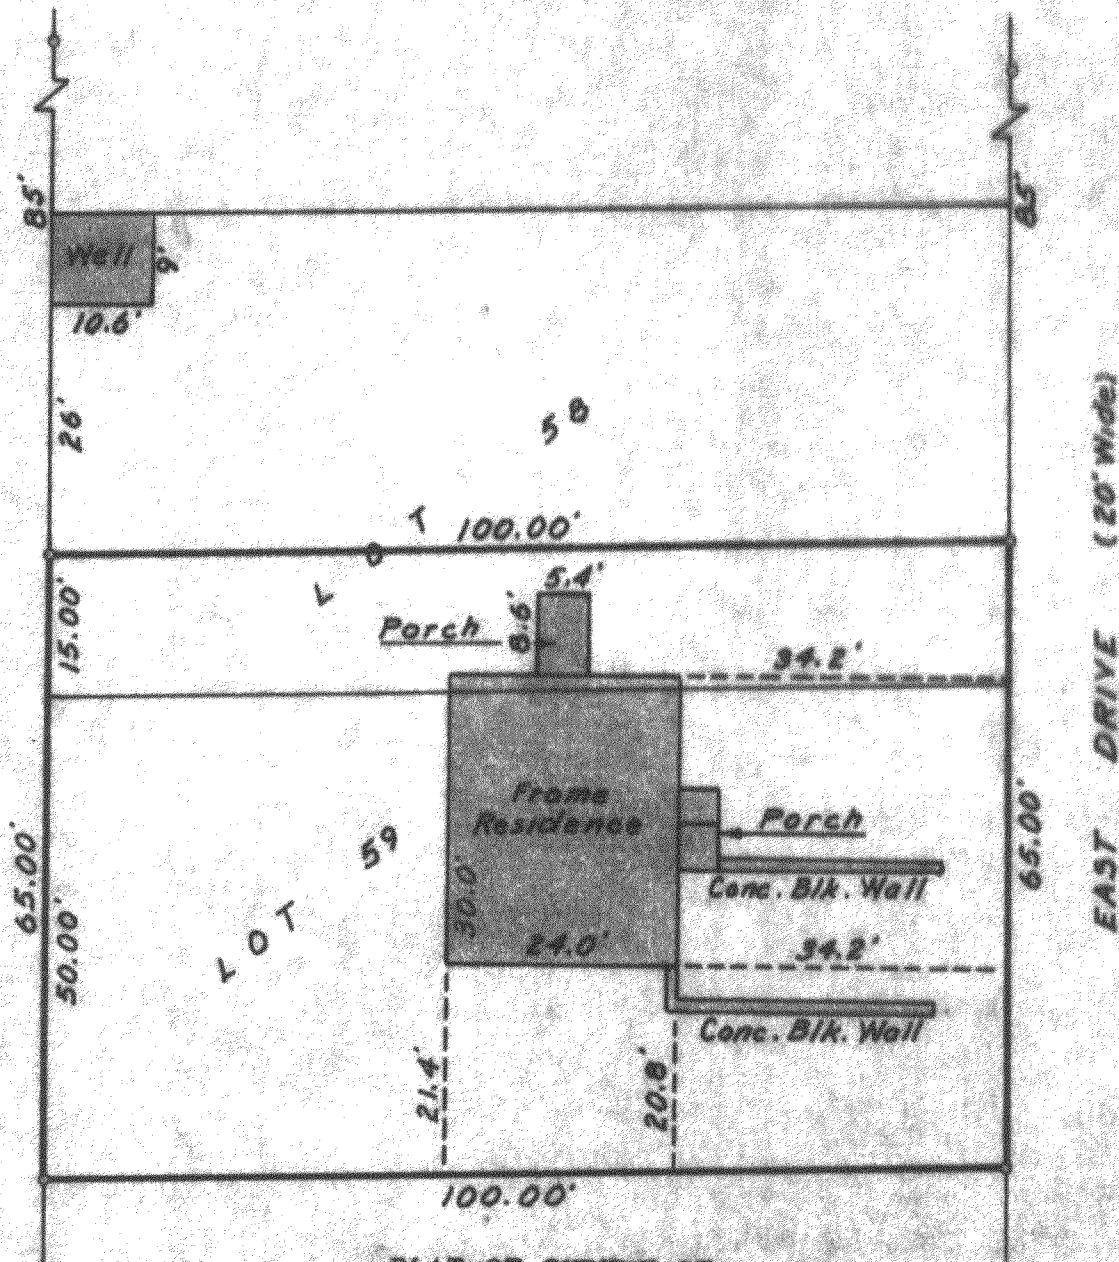

PLAT OF SURVEY OF

Lot 59 and the South 15 feet of Lot 58, Golf Hills Subdivision,  
located in Section 31, T 1 N, R 18 E, Walworth County, Wisconsin.

I, Harold H. Kolb, do hereby certify that I have surveyed the property  
hereon described according to the official records, and that the plat  
hereon is a correct representation of the lot lines and the principal  
lines of the buildings thereon.

*Harold H. Kolb*

Harold H. Kolb, Wisconsin Surveyor, S-187  
DATE: October 3, 1963