


HAROLD H. KOLB

REGISTERED PROFESSIONAL LAND SURVEYOR
LAKE GENEVA, WISCONSIN LOT 30
100.10'

WEST DRIVE - 20' WIDE

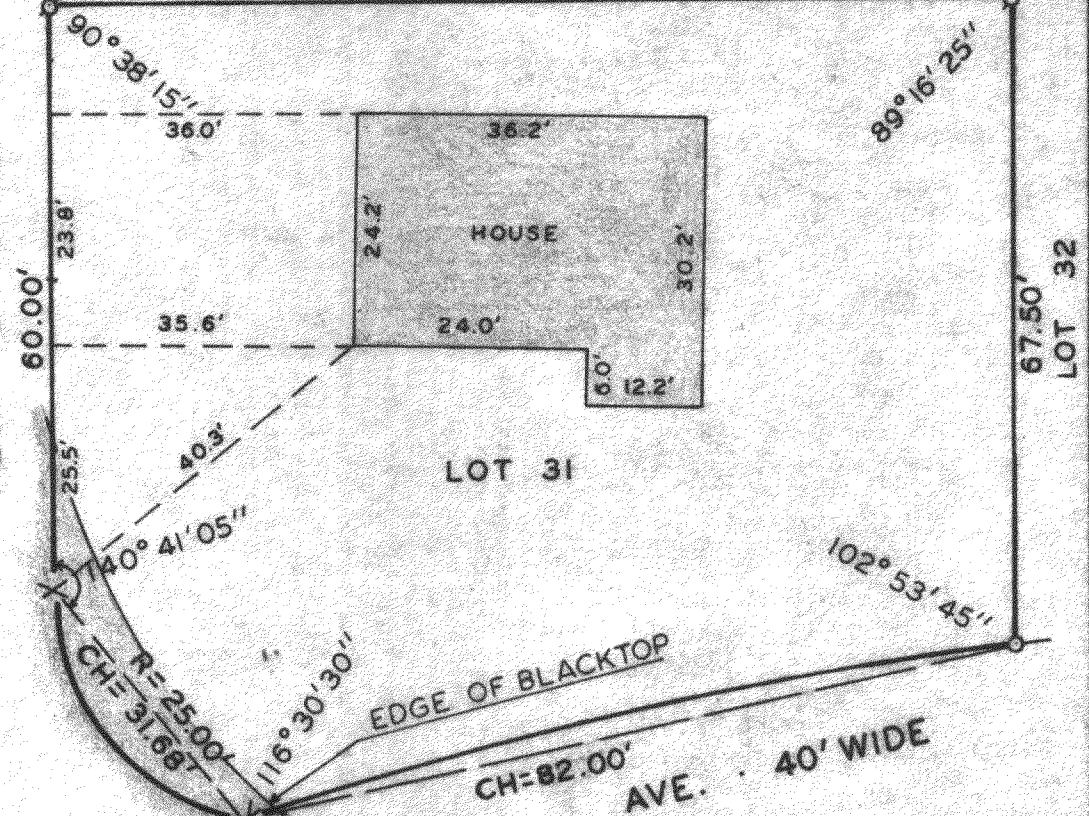

ACCURACY: Distances $\pm 0.01'$
Angles $\pm 05''$
Error of closure
less than $1/3000$


N



SCALE - 1" = 20'

LEGEND

- φ - IRON PIPE FOUND
- - IRON PIPE PLACED
- - CONCRETE MONUMENT
- x - Railroad Spike Set

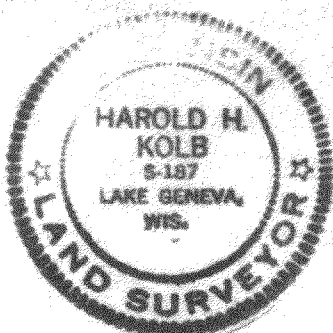

PLAT OF SURVEY OF

Lot 31, Lake Geneva Golf Hills Add.,
T2N, R18E, Walworth County, Wisconsin

OWNER: Kevin Schoen

I, HAROLD H. KOLB, DO HEREBY CERTIFY THAT I HAVE
SURVEYED THE PROPERTY HEREON DESCRIBED ACCORDING
TO THE OFFICIAL RECORDS, AND THAT THE PLAT HEREON
IS A CORRECT REPRESENTATION OF THE LOT LINES.

Harold H. Kolb

HAROLD H. KOLB
WISCONSIN REGISTERED LAND SURVEYOR, S-187
DATE Oct. 2, 1974

218-192