



Plat of Survey

of

Lot 9 of Meadow Hill Farms,

a subdivision located in the Southeast 1/4 of the Southeast 1/4 of Section 32,
Town 2 North, Range 18 East, Town of Lyons, Walworth County, Wisconsin.

Surveyed for: **Knopp Trust**
6653 Cobble Creek Drive
Lake Geneva, Wisconsin. 53147

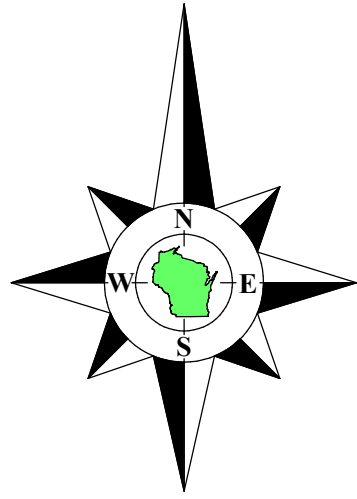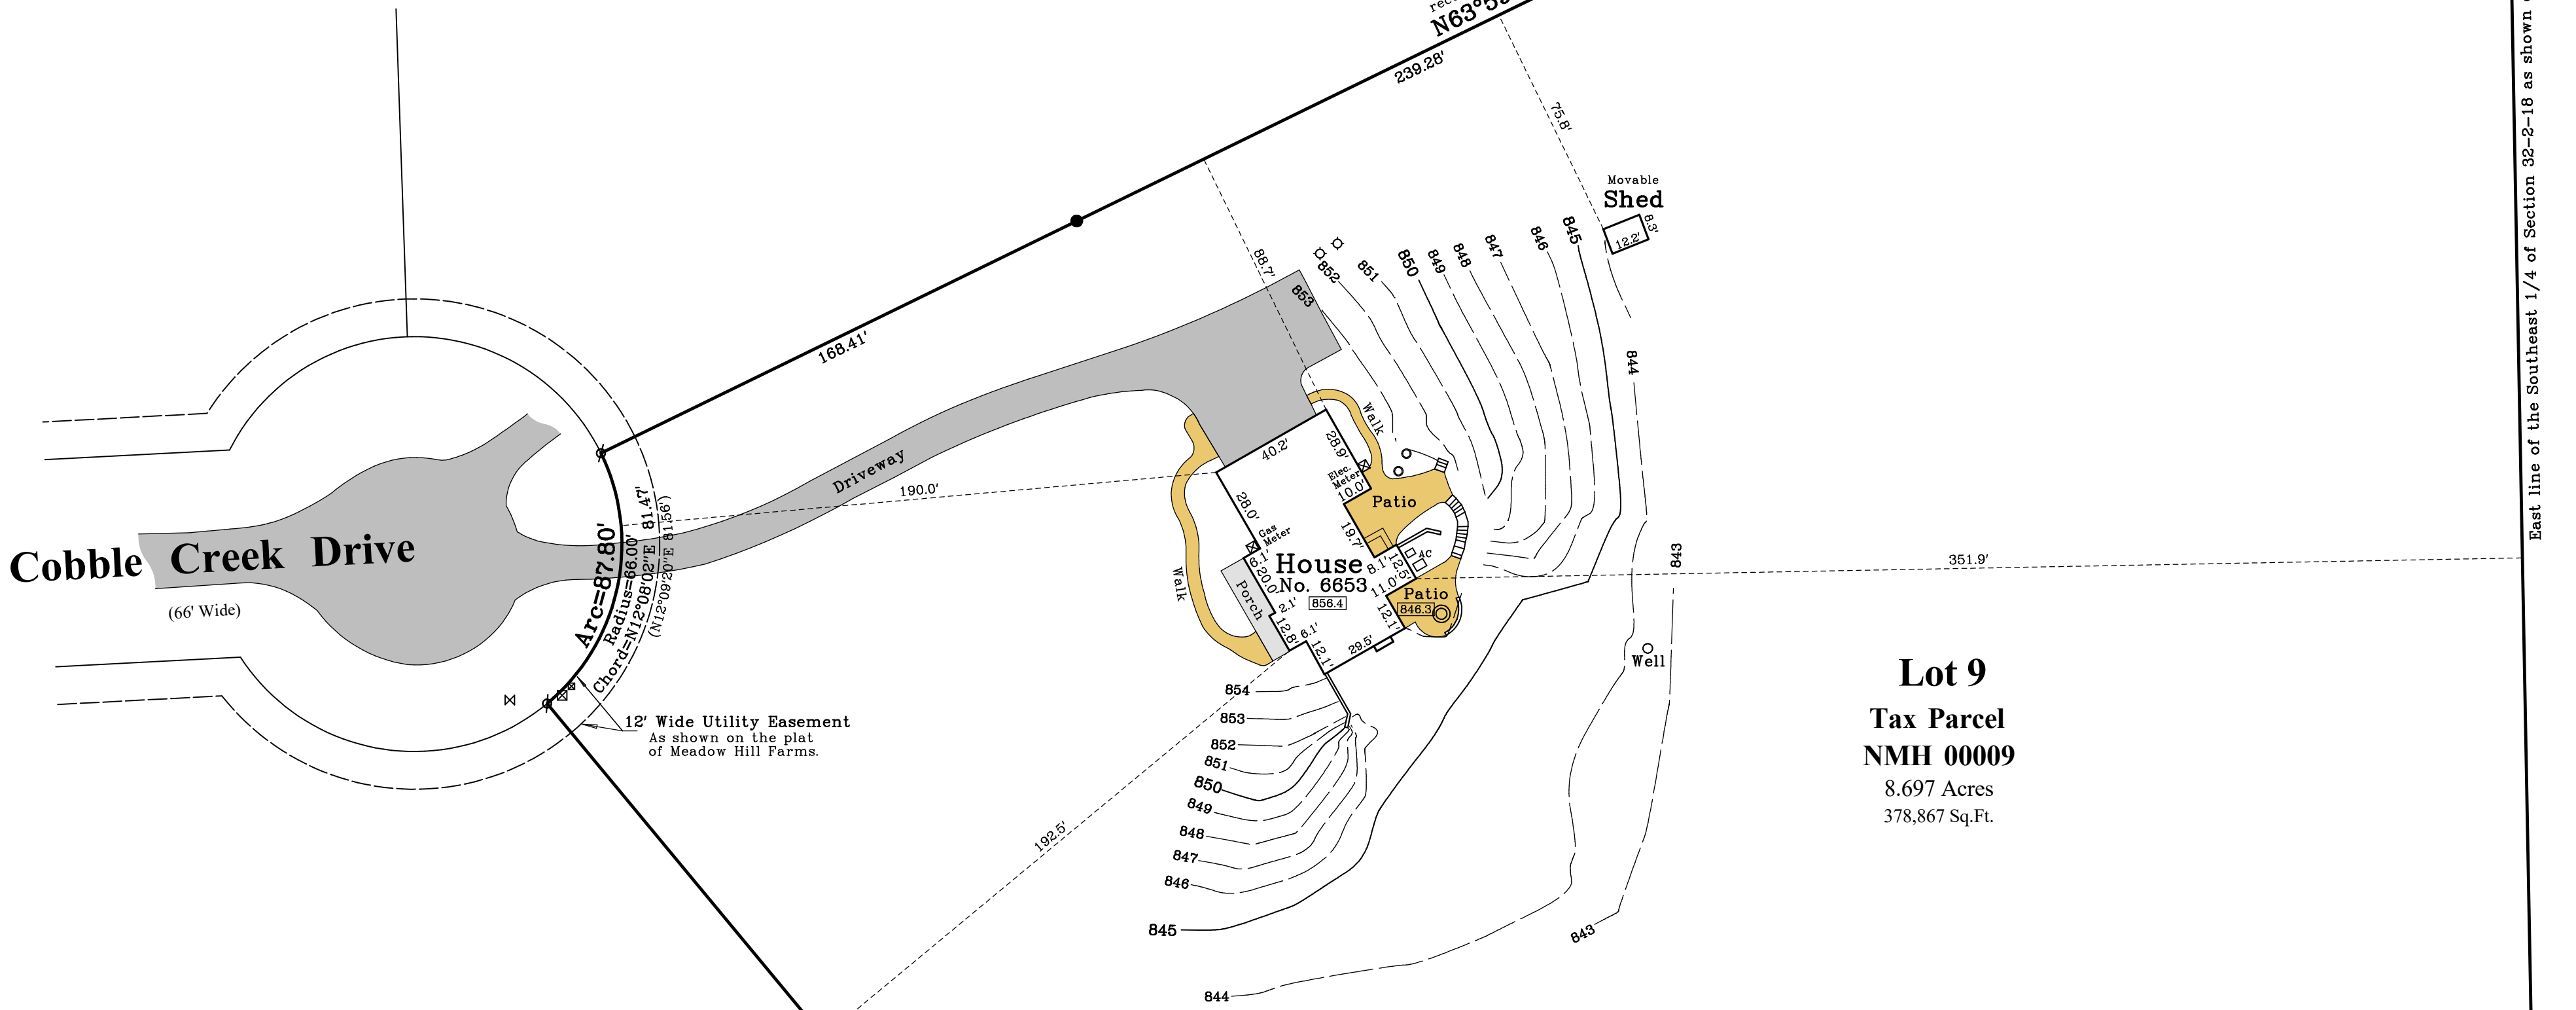

Bearings referenced to the South line of the Southeast 1/4 of Section 32-2-18,
recorded as N89°18'55\"/>

Coordinates are referenced to the Wisconsin State
Plane Coordinate System, South Zone, (NAD-27).

Lot 10
Meadow Hill Farms

Tax Parcel
NLY 3300003

South 1/4 Corner
Section 32-2-18
(N. 216,296.38)
(E. 2,432,464.95)

North 1/4 Corner
Section 5-1-18
(N. 216,296.71)
(E. 2,432,493.25)


recorded as N69°21'02\"/>

Town Line Road

S89°15'00\"/>

Southeast Corner
Section 32-2-18
(N. 216,328.47)
(E. 2,435,118.63)

Northwest Corner
Section 4-1-18
(N. 216,328.63)
(E. 2,435,132.06)

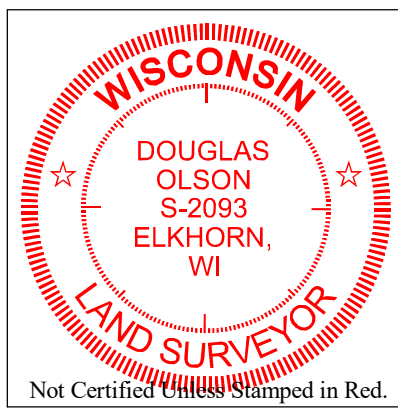

Notes:

- This Plat of Survey is not certified unless signed and sealed in red ink.
- This survey is subject to Wisconsin lien laws. This Plat of Survey is the notice of intent to file lien. Lien waiver required.
- The Survey Date shown on this Plat of Survey is the completion date of the field work.

Copyright © 2022 by Olson Land Surveying, LLC.

All rights reserved. No part of this survey plat may be reproduced or transmitted in any form by any means - graphic, electronic, or mechanical, including photocopying, tracing, or information storage and retrieval systems - without permission in writing from Douglas G. Olson, Olson Land Surveying, LLC.

I hereby certify that I have surveyed the above described property in compliance with Chapter A-E 7 of the Wisconsin Administrative Code and that the map hereon is correct to the best of my professional knowledge and belief and shows the size and location of the property, its exterior boundaries, the location and dimensions of all visible structures thereon, boundary fences, apparent easements and roadways and visible encroachments, if any.

This survey is made for the exclusive use of the present owners of the property, and also those who purchase, mortgage or guarantee title thereto, within one year from the date hereof.

Douglas G. Olson
Wisconsin Professional Land Surveyor - 2093

Sheet 1 of 1 Sheets
Drawing Name:
Job Reference Number
2022.095

Legend of Symbols & Abbreviations


- Found County Section Corner
- Found Iron Pipe
- Found Iron Rod
- Set Iron Pipe, 1\"/>

N North
S South
E East
W West
In Bearings
° Degrees
' Minutes
\"/>



45 South Wisconsin Street | P.O. Box 322
Elkhorn, Wisconsin. 53121
Telephone: (262) 723-3434
Facsimile: (262) 723-8044
Email: doug@olsonsurveying.com
Website: www.olsonsurveying.com

Scale in Feet
1" = 40'

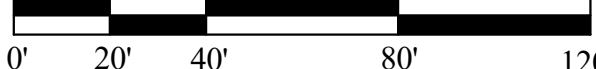

Survey date: July 27, 2022.
Revisions:

2022.095