


HAROLD H. KOLB

REGISTERED PROFESSIONAL LAND SURVEYOR
LAKE GENEVA, WISCONSIN

LAWTON AVENUE

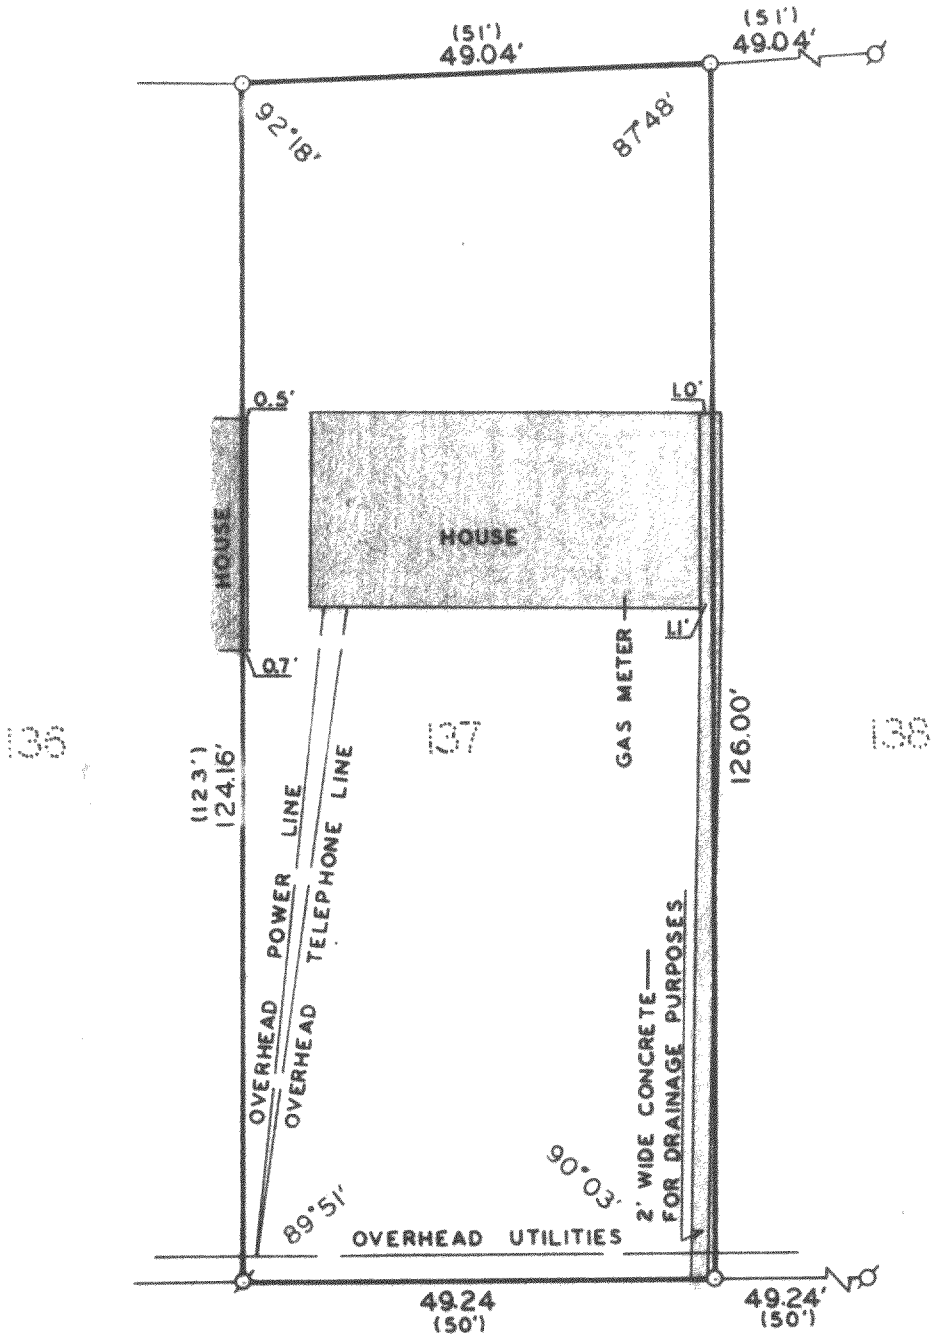

ORDERED BY:


PLAT OF SURVEY OF

LOT 137, LAKE GENEVA GOLF HILLS SUBDIVISION, T2N, R18E,
WALWORTH COUNTY, WISCONSIN.

NOTE: RESURVEY USING
THE DISTANCES FROM FIELD
NOTES BY LLOYD L. JENSEN
R. L. S. NO. S-211,
DATED MAY, 1954.

I HAVE SURVEYED THE ABOVE DESCRIBED
PROPERTY AND THE ABOVE MAP IS A TRUE
REPRESENTATION THEREOF AND SHOWS THE
SIZE AND LOCATION OF THE PROPERTY, ITS
EXTERIOR BOUNDARIES, THE LOCATION OF
ALL APPARENT EASEMENTS AND ROADWAYS
AND VISIBLE ENCROACHMENTS, IF ANY.

THIS SURVEY IS MADE FOR THE USE OF
THE PRESENT OWNERS OF THE PROPERTY,
AND ALSO THOSE WHO PURCHASE, MORTGAGE,
OR GUARANTEE THE TITLE THERETO WITHIN
ONE (1) YEAR FROM THE DATE HEREOF.

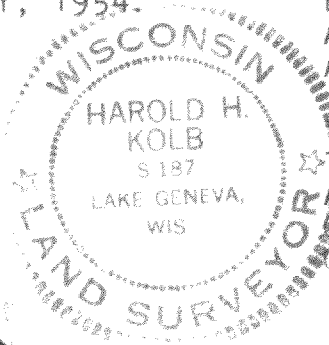

SCALE: 1"=20'
LEGEND

- O — IRON PIPE PLACED, 1" x 24" 1.13 LB./LIN. FT.
- — CONCRETE MONUMENT, 5" DIA. x 30"
- () — AS PLATTED
- σ — IRON PIPE FOUND

Harold H. Kolb
HAROLD H. KOLB
WISCONSIN REGISTERED LAND SURVEYOR, S-187
DATE 12-9-77