


KOLB LAND CONSULTING, INC.
LAND SURVEYING • SUBDIVIDING • LAND PLANNING



LAKE GENEVA, WISCONSIN 53147

WHITEWATER, WISCONSIN 53190

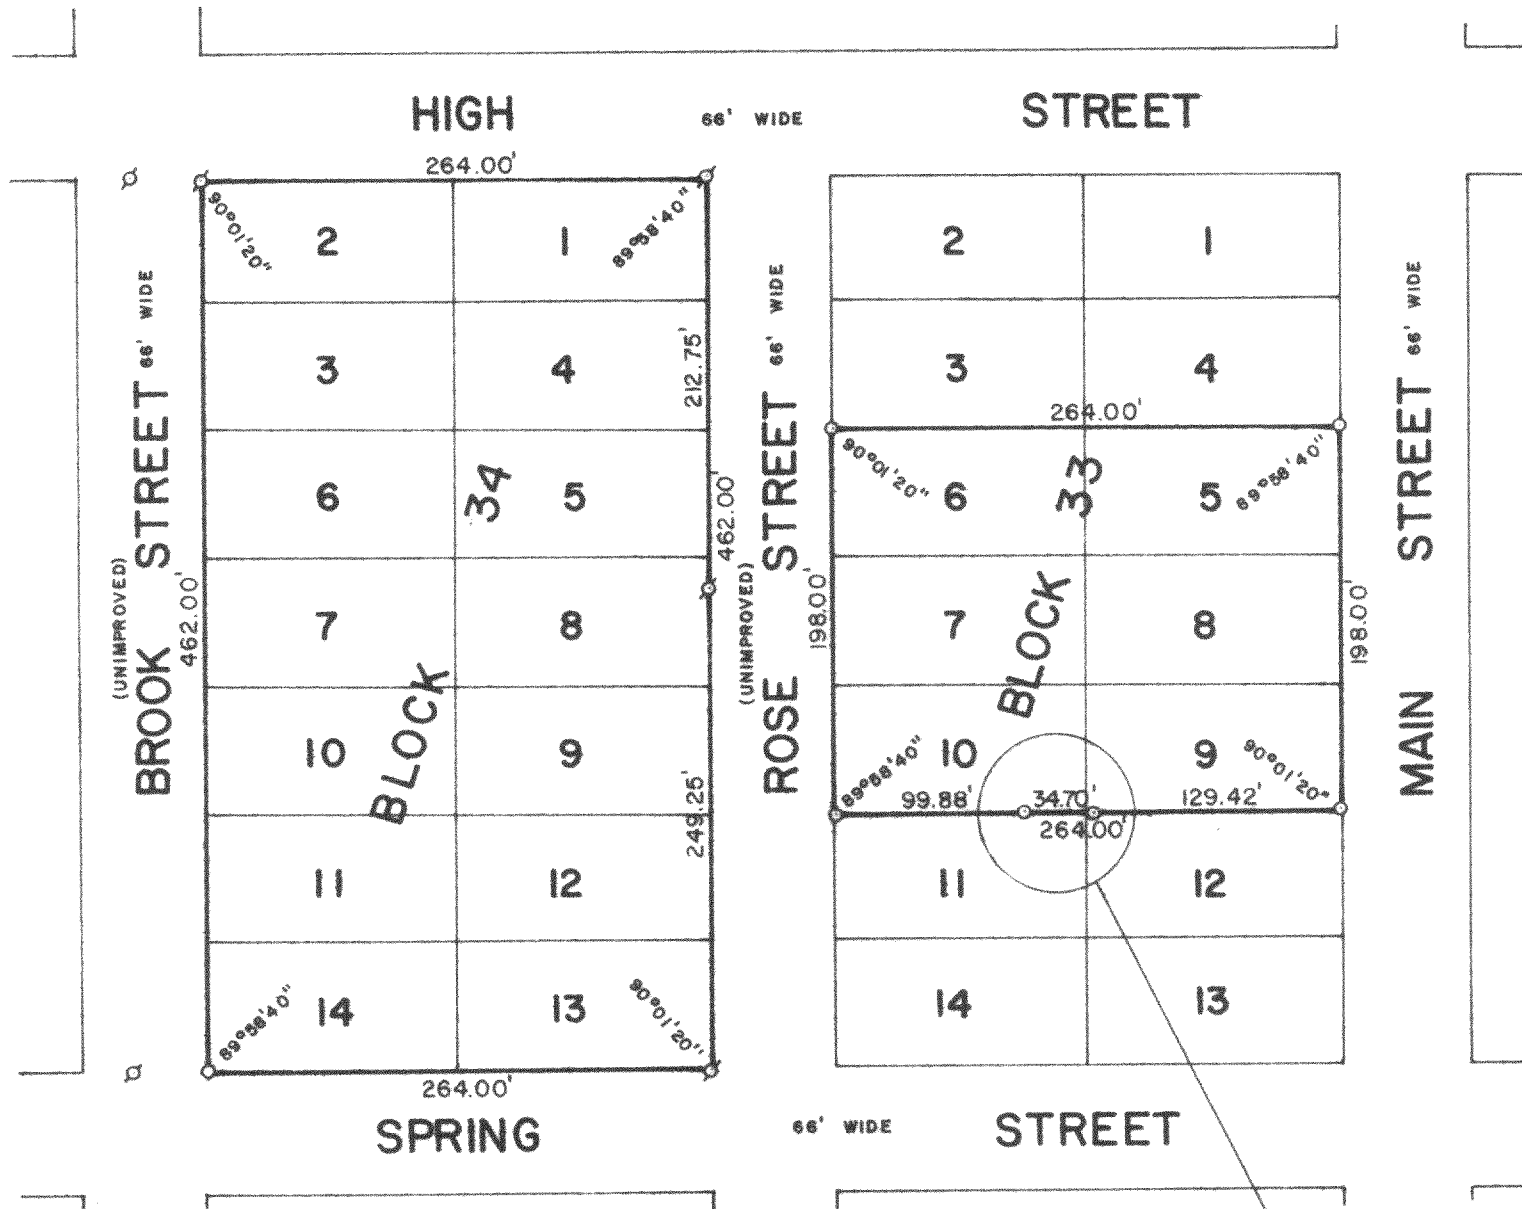


PLAT OF SURVEY OF
LOTS 1-14, BLOCK 34 AND LOTS 5-10, BLOCK
33, SPRINGFIELD SUBDIVISION, LOCATED IN
SECTION 7, T 2 N, R 18 E, WALWORTH COUNTY,
WISCONSIN.

ORDERED BY: GENEVA LAKES AREA REALTORS
838 MAIN STREET
LAKE GENEVA, WISCONSIN 53147

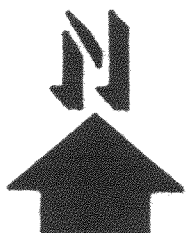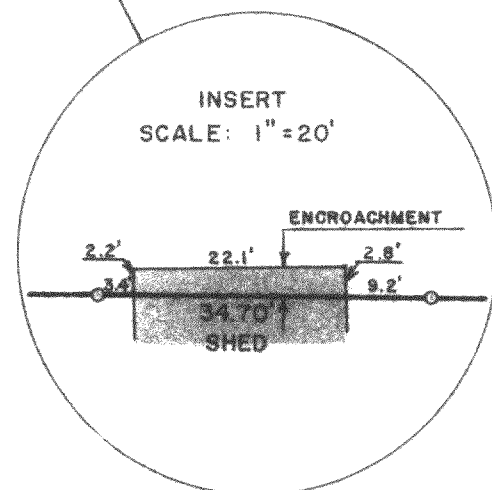

SCALE: 1"=100'

- ⊙ - IRON PIPE FOUND
- - IRON PIPE PLACED

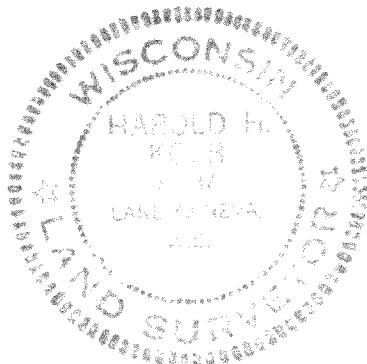

I, HAROLD H. KOLB, DO HEREBY CERTIFY
THAT I HAVE SURVEYED THE PROPERTY
HEREON DESCRIBED ACCORDING TO THE
OFFICIAL RECORDS, AND THAT THE PLAT
HEREON IS A CORRECT REPRESENTATION
OF THE LOT LINES TO THE BEST OF MY
KNOWLEDGE AND BELIEF.

Harold H. Kolb

HAROLD H. KOLB
WISCONSIN REGISTERED LAND SURVEYOR, S-187
DATE AUG. 11, 1982