


KOLB LAND CONSULTING, INC.
LAND SURVEYING • SUBDIVIDING • LAND PLANNING

LAKE GENEVA, WISCONSIN 53147



WHITEWATER, WISCONSIN 53190

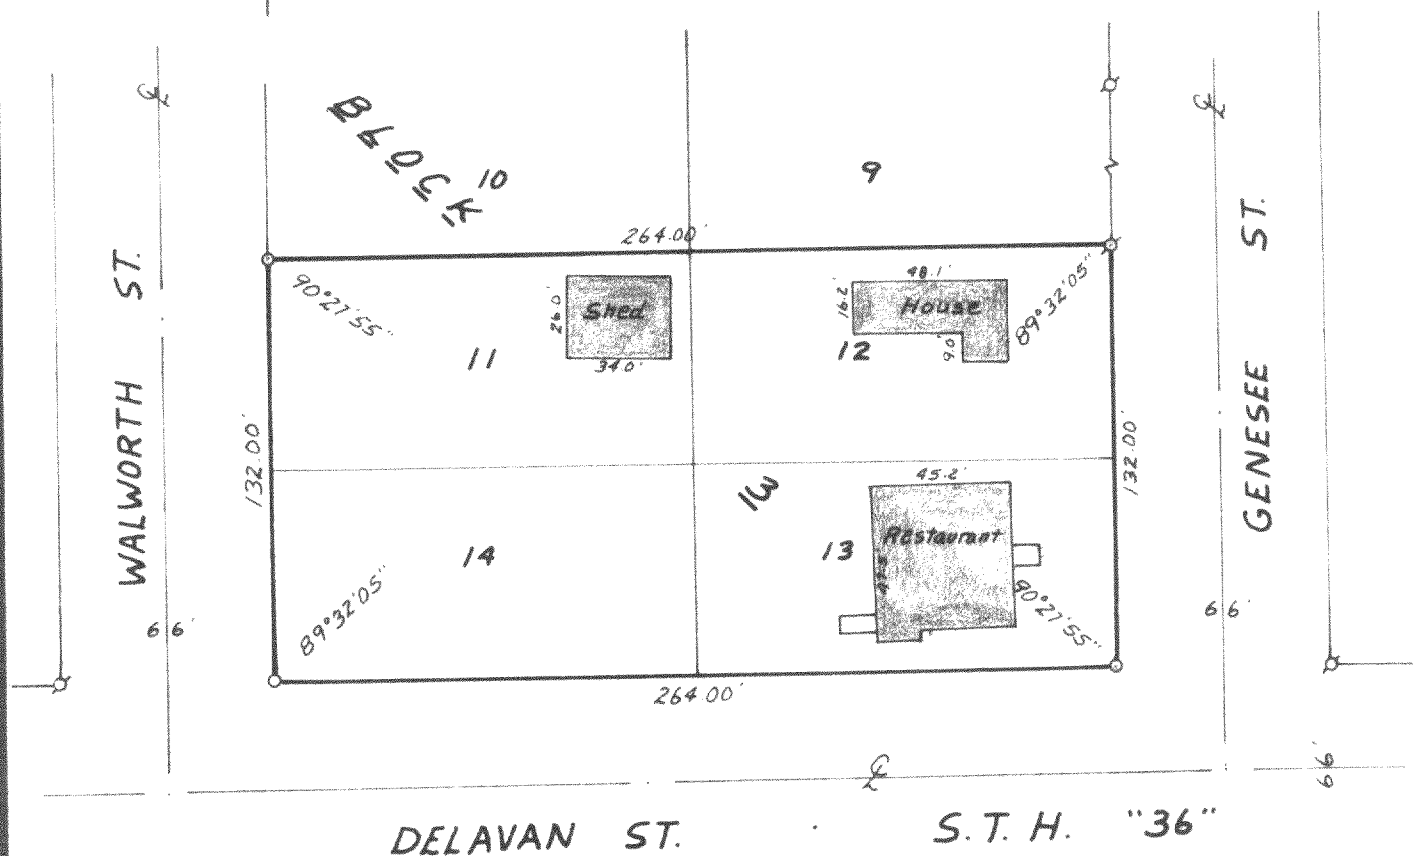

PLAT OF SURVEY OF

LOTS 11, 12, 13 AND 14, BLOCK 3, MAP OF SPRINGFIELD,
LOCATED IN THE SOUTH 1/2 OF SECTION 7, T 2 N, R 18 E,
TOWN OF LYONS, WALWORTH COUNTY, WISCONSIN.

ORDERED BY: WARREN KETCHPAW
1792 GENESEE
SPRINGFIELD, WI. 53176

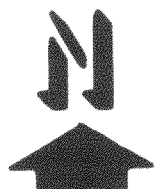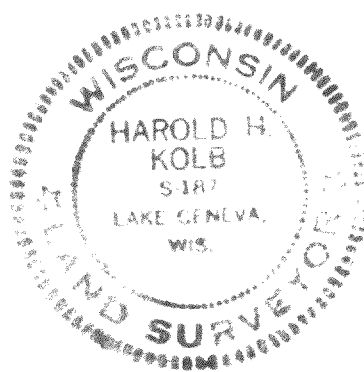

SCALE 1"=60'

LEGEND
⊙ IRON PIPE FOUND
○ IRON PIPE 1"X24" SET

I, HAROLD H. KOLB, DO HEREBY CERTIFY
THAT I HAVE SURVEYED THE PROPERTY
HEREON DESCRIBED ACCORDING TO THE
OFFICIAL RECORDS, AND THAT THE PLAT
HEREON IS A CORRECT REPRESENTATION
OF THE LOT LINES AND THE PRINCIPAL
LINES OF THE BUILDINGS THEREON TO
THE BEST OF MY KNOWLEDGE AND BELIEF.

Harold H. Kolb

WISCONSIN REGISTERED LAND SURVEYOR, S-187
DATE FEBRUARY 10, 1983