



WALWORTH COUNTY
SURVEYING & MAPPING
LAKE GENEVA, WISCONSIN

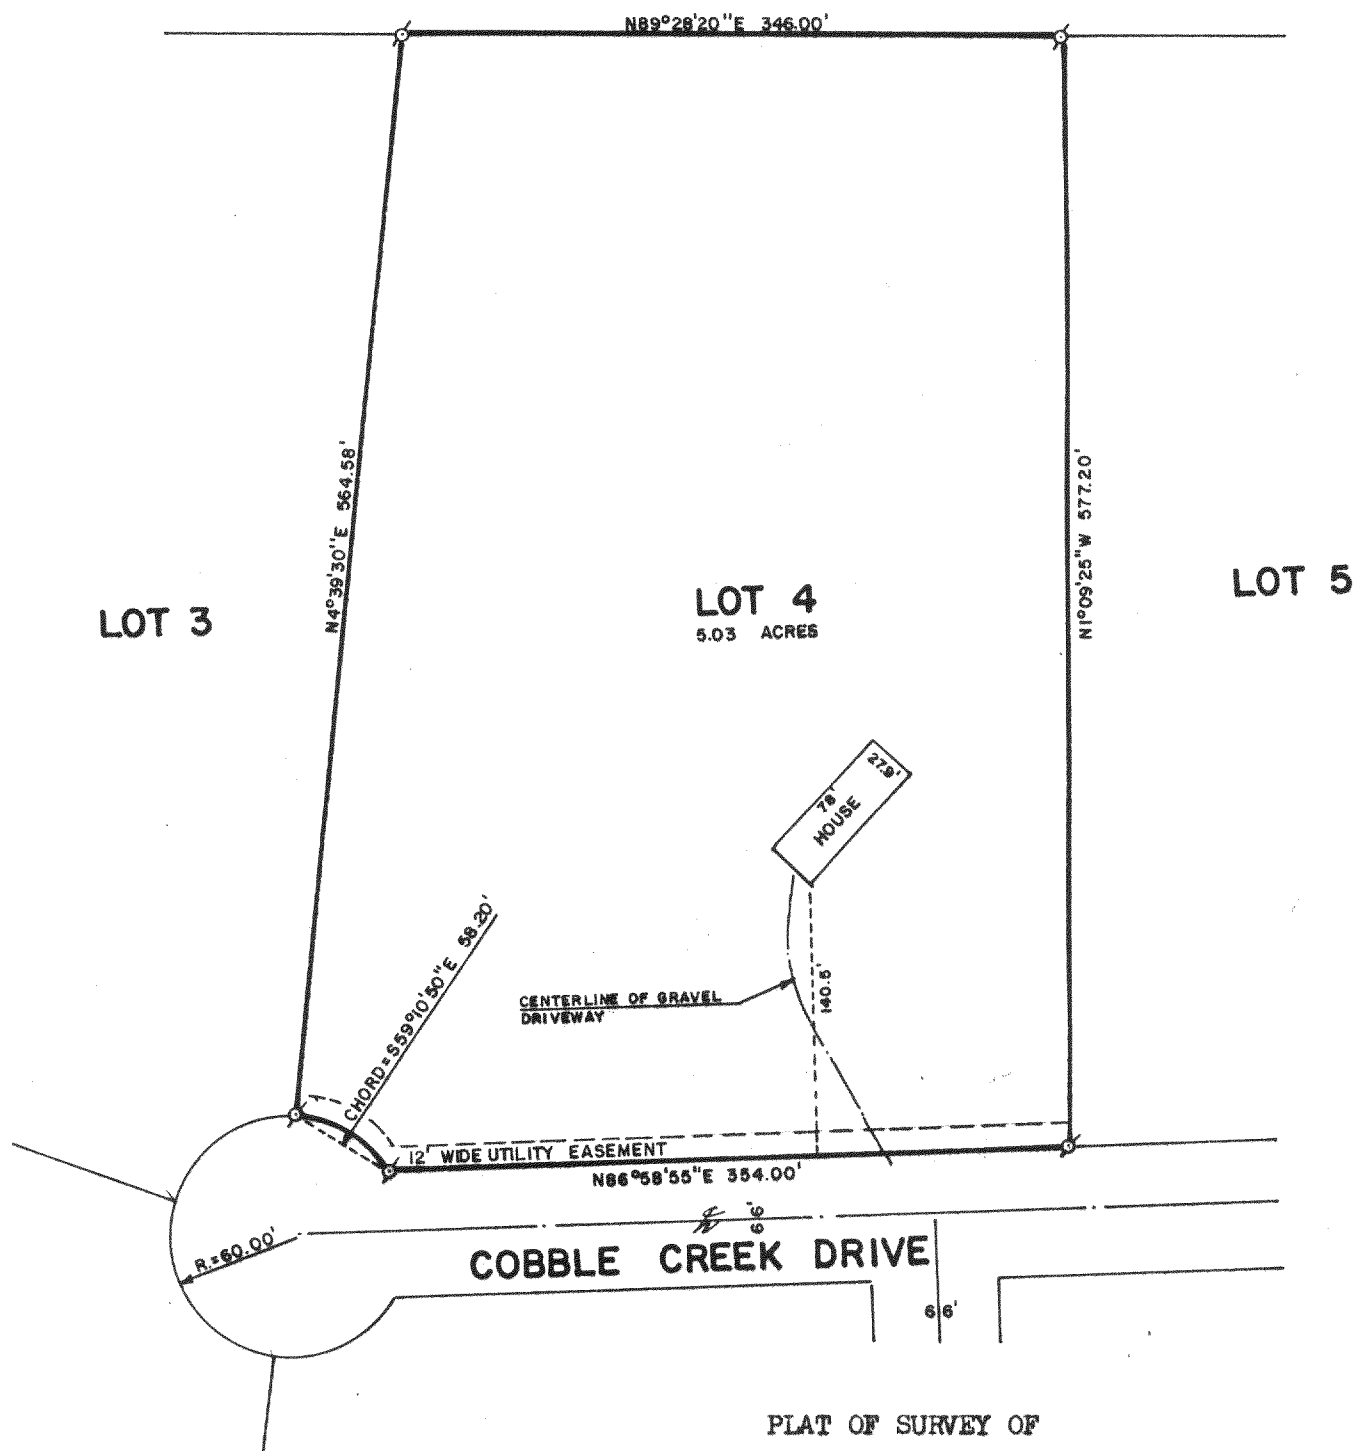

PLAT OF SURVEY OF
LOT 4 OF MEADOW HILL FARMS, LOCATED
IN SECTION 32, T 2 N, R 18 E, WALWORTH
COUNTY, WISCONSIN.

ORDERED BY: JOHN SARNOWSKI
PRT. 3, P. O. BOX 1060
LAKE GENEVA, WISCONSIN 53147

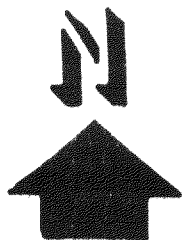

SCALE: 1"=100'

⌀ - IRON PIPE FOUND

I, ROBERT M. BAERENWALD, DO HEREBY CERTIFY THAT I
HAVE SURVEYED THE PROPERTY HEREON DESCRIBED ACCORDING
TO THE OFFICIAL RECORDS AND THAT THE PLAT HEREON IS A
CORRECT REPRESENTATION OF THE PROPERTY LINES TO THE
BEST OF MY KNOWLEDGE AND BELIEF.

Robert M. Baerenwald
ROBERT M. BAERENWALD
WISCONSIN REGISTERED LAND SURVEYOR, S-1508

DATE May 2, 1987 JOB NO. 0994

NOTE: THIS IS NOT A CERTIFIED COPY UNLESS SEALED.