

**ABELL
SURVEYING & MAPPING
DELAVER, WISCONSIN 53115
414-728-6737**

N.W. CORNER SECTION 16-2-18

(N 89°11'45"E 656.29')

(N 0°39'40"W 661.22')

(N 89°11'10"E 656.49') 656.74'

(623.49') 623.74'

33.00'

89°51'40"

330.63'

33.00'

89°51'40"

330.63'

33.00'

89°51'40"

LOT 1



4.98 ACRES

FOUND IRON PIPE 4.60 FEET SOUTH
OF CORNER, SET IRON ROD AT
CORNER.

PLAT OF SURVEY OF

LOT 1 OF CERTIFIED SURVEY MAP NO. 1254, AS RECORDED
IN VOLUME 6 OF CERTIFIED SURVEY MAPS ON PAGES 21 AND
22 AS DOCUMENT NUMBER 85306, LOCATED IN THE NORTHWEST
1/4 OF SECTION 16, T2N,R18E, WALWORTH COUNTY, WISCONSIN.

ORDERED BY: BARB HILL
ROUTE 2, BOX 300-11
LAKE GENEVA, WI. 53147

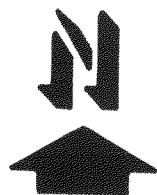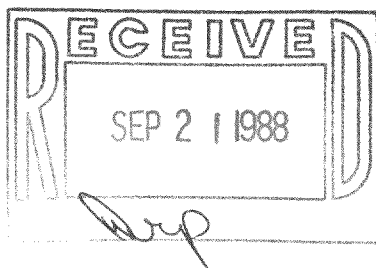

SCALE - 1"=200'

LEGEND

- ⊗ - IRON PIPE FOUND
- - IRON ROD SET
- () - RECORDED AS

I, DAVID F. ABELL, DO HEREBY CERTIFY
THAT I HAVE SURVEYED THE PROPERTY
HEREON DESCRIBED ACCORDING TO THE
OFFICIAL RECORDS AND THAT THE PLAT
HEREON IS A CORRECT REPRESENTATION
OF THE PROPERTY LINES TO THE BEST OF
MY KNOWLEDGE AND BELIEF.

David F. Abell

DAVID F. ABELL
WISCONSIN REGISTERED LAND SURVEYOR, S-1596

July 25, 1988

DATE: JOB NUMBER - 88153

NOTE: THIS IS NOT A CERTIFIED COPY UNLESS SEALED.

NA1254-1